

Clarke
5 C3
1-67

P

MISSISSIPPI BOARD OF WATER COMMISSIONERS

WATER WELL DRILLERS LOG

Date: JAN 5, 1967, Driller MCDONALD + HILL County CLARK
(When well drilled) (Name) (Where well is located)

(1) Owner of Land: <u>ROYCE WILLIAMS</u> (Name) <u>R#1 MERIDIAN</u> (Address)	Description & Color of Materials Sand, Clay, Red Clay, Shell, etc.	Thick- ness Feet	Depth Feet
	<u>CLAY</u>	<u>10</u>	<u>10</u>
(2) Location: <u>SW 1/4, NW 1/4, Sec. 8</u> ^{N E} <u>T4 R16</u> <u>3 1/2</u> miles <u>SOUTH</u> , of <u>CLARKDALE</u> (distance) (direction) (Nearest Town)	<u>SAND ST CLAY</u>	<u>65</u>	<u>75</u>
(3) Topography: <u>X</u> (Hilly) (Flat) (Level)			
(4) Purpose of Well: <u>DOMESTIC</u> (Domestic Irrigation Municipal, Industrial, Other)			

Information upon completion of well:

(1) Diameter: 3 1/2 inches. TEST HOLE

(2) Total Depth: 75' feet.

(3) Water Level: 68' feet below top of ground.

(4) Cased to: 71', Size 2"

(5) Screen: Size 2", Length 4'

(6) Were any formations sealed against pollution?
 yes, no.

If YES depth of formation _____


Why _____

Drillers Remarks: _____

Yield in gpm: 8

Size pump: 1/2 hp Red pump

Type power: 230 VOLTS

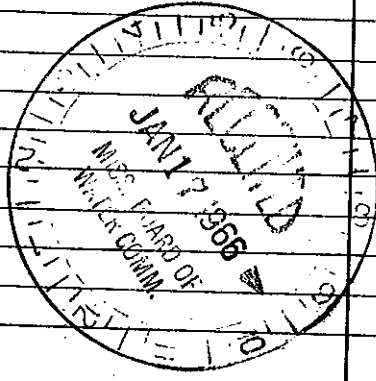

Mail this copy to Board of Water Commissioners 429 Miss. St. Jackson, Miss.