

CLARKE MISSISSIPPI BOARD OF WATER COMMISSIONERS

WATER WELL DRILLERS LOG

Date: 7-27, 1964, Driller: TERRY County LAUD
(Name)

6
C5
7-27-64

5

(1) Owner of Land: <u>J.C. McPHERSON</u> <small>(Name)</small>	Description & Color of Materials Sand, Clay, Red Clay, Shell, etc.	Thick- ness Feet	Depth Feet
<u>Rt 1 DAITMAN, Miss</u> <small>(Address)</small>	<u>yellow clay</u>	<u>18'</u>	<u>18'</u>
(2) Location: <u>1/4</u> , <u>1/4</u> , Sec. <u>17</u> <u>4N16E</u> <small>T. R.</small>	<u>red sand & rock</u>	<u>74'</u>	<u>92'</u>
<u>15</u> miles <u>S</u> of <u>MDU</u> <small>(distance) (direction) (Nearest Town)</small>			
(3) Topography: <input checked="" type="checkbox"/> <u>Level</u> <small>(Hilly) (Flat) (Level)</small>			
(4) Purpose of Well: <u>DOMESTIC</u> <small>(Domestic Irrigation Municipal, Industrial, Other)</small>			


Information upon completion of well:

- (1) Diameter 2" inches.
- (2) Total Depth 92' feet.
- (3) Water Level 50' feet below top of ground.
- (4) Cased to 85', Size 2"
- (5) Screen: Size 2", Length 6'
- (6) Were any formations sealed against pollution?
 yes, no.

If YES depth of formation _____

Why _____

Drillers Remarks: _____

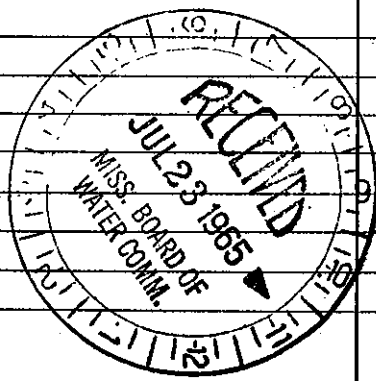

(Use Back Side)

Well No.

Mail this copy to Board of Water Commissioners 429 Miss. St. Jackson, Miss.