

6 BCC

4-26-63

WATER WELL DRILLERS LOG

Mrs. Donald & Hill, Inc.


Date: 4-26, 1963, Driller: Lead Chatham County Clarendon
(Name)

(1) Owner of Land: Frank Riley
(Name)
Quitman, Route one
(Address)
(2) Location: $\frac{1}{4}$, $\frac{1}{4}$, Sec 29 $\frac{4N}{16E}$ T R
8 miles north, of Quitman
(distance) (direction) (Nearest Town)
(3) Topography: Hilly (Hilly) (Flat) (Level)
(4) Purpose of Well: Domestic
(Domestic Irrigation
Municipal, Industrial, Other)

Description & Color of Materials Sand, Clay, Red Clay, Shell, etc.	Thick- ness Feet	Depth Feet
Clay	0	18
Sand & sandy clay	18	40
Sand	40	100
Shale	100	115
Limey shale & lime	115	138
Sand w/ lime streaks	138	148
Shale	148	155
Glyc. lime w/ shale str	155	165
Limey shale & lime	165	253
Sand	253	268
Shale	268	270
Sand	270	280
Fine sand	280	290
Sandy shale	290	300

Information upon completion of well:

(1) Diameter 3 1/4 inches.
(2) Total Depth 300 feet.
(3) Water Level 110 feet below top of ground.
(4) Cased to 194, Size 4
(5) Screen: Size _____, Length _____
(6) Were any formations sealed against pollution?
_____ yes, _____ no.
If YES depth of formation _____
Why _____
Drillers Remarks: Can be
screened 253-268 or
270-280 w/ #12 slot.

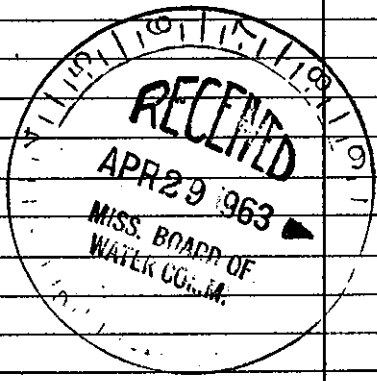

Well No.

(Use Back Side)