

CLARKE

F 07

WATER WELL DRILLERS LOG

Date: 1-5-65, 1965, Driller: M^{rs} Donald & Hill, Inc County Clarke
(Name)

(1) Owner of Land: <u>VAN CHANCELOR</u> (Name)	Description & Color of Materials Sand, Clay, Red Clay, Shell, etc.	Thick- ness Feet	Depth Feet
<u>QUITMAN MISS</u> (Address)	<u>CLAY</u>	<u>0</u>	<u>20</u>
(2) Location: <u>1/4, 1/4, Sec. 32</u> <u>KNIGE</u> T R	<u>SAND ST CLAY</u>	<u>20</u>	<u>78</u>
<u>7</u> miles <u>N-W</u> , of <u>Quitman</u> (distance) (direction) (Nearest Town)	<u>SANDY LIME</u>	<u>78</u>	<u>125</u>
(3) Topography: <u>X</u> (Hilly) (Flat) (Level)	<u>SHALE ST ROCK</u>	<u>125</u>	<u>235</u>
(4) Purpose of Well: <u>DOMESTIC</u> (Domestic Irrigation Municipal, Industrial, Other)	<u>SAND</u>	<u>235</u>	<u>275</u>

Information upon completion of well:

(1) Diameter 4" WELL inches.

(2) Total Depth 275' feet.

(3) Water Level 84' feet below top of ground.

(4) Cased to 150', Size 4" BLACK PIPE

(5) Screen: Size NONE, Length _____


(6) Were any formations sealed against pollution?
 _____ yes, no.

If YES depth of formation _____

Why _____

Drillers Remarks: _____

3

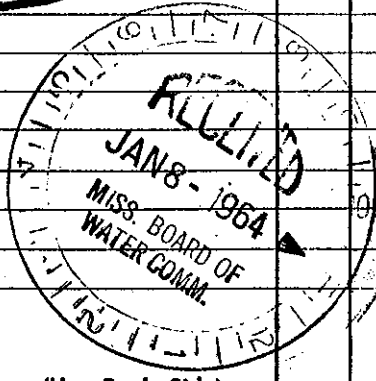

Well No. _____

(Use Back Side)

Mail this copy to Board of Water Commissioners 429 Miss. St. Jackson, Mis: