

CLARKE MISSISSIPPI BOARD OF WATER COMMISSIONERS


6 CB

WATER WELL DRILLERS LOG

Date: 6-30-64, 1964, Driller: M. E. Dunell & Hill Inc County Handmade

(Name)

| (1) Owner of Land | Description & Color of Materials Sand, Clay, Red Clay, Shell, etc. | Thick- ness Feet | Depth Feet |
|--|---|------------------------|---------------|
| MORRIS GRIFFIN (Name) Rt. #1, Quitman, Miss (Address) | CLAY | 0 | 20 |
| (2) Location: _____ 1/4, _____ 1/4, Sec. 29 4N 16E T R 8 miles north of Quitman (distance) (direction) (Nearest Town) | CLAY ST SAND SAND | 20 40 | 40 110 |
| (3) Topography: <input checked="" type="checkbox"/> (Hilly) <input type="checkbox"/> (Flat) <input type="checkbox"/> (Level) | | | |
| (4) Purpose of Well: DOMESTIC (Domestic Irrigation Municipal, Industrial, Other) | | | |
| Information upon completion of well: | | | |
| (1) Diameter 3 1/4 inches. | | | |
| (2) Total Depth 110 feet. | | | |
| (3) Water Level 75 feet below top of ground. | | | |
| (4) Cased to 105 feet, Size 9 inches. | | | |
| (5) Screen: Size 2 inches, Length 4 feet. | STEEL | | |
| (6) Were any formations sealed against pollution? _____ yes, _____ no. | | | |
| If YES depth of formation _____ | | | |
| Why _____ | | | |
| Drillers Remarks: | | | |

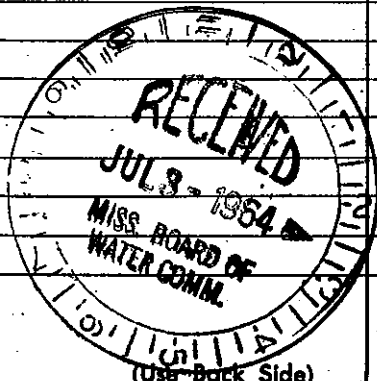

Well No.

Mail this copy to Board of Water Commissioners 429 Miss. St. Jackson, Miss.