

WATER WELL DRILLERS LOG

Date: 1-21-61, 1962, Driller: MCDONALD HILL County CLARK

(1) Owner of Lands	Description & Color of Materials Sand, Clay, Red Clay, Shell, etc.	Thick- ness Feet	Depth Feet
<u>J.L. MASSINGALE</u> (Name)	<u>CLAY</u>	<u>0</u>	<u>18</u>
<u>WEST ENTERPRISE</u> (Address)	<u>CLAY STRAND</u>	<u>18</u>	<u>32</u>
(2) Location: <u>1/4</u> , <u>1/4</u> , Sec. <u>20</u> <u>UN</u> <u>W</u> <u>E</u>	<u>SAND</u>	<u>32</u>	<u>126</u>
<u>8</u> miles <u>EAST</u> of <u>ENTERPRISE</u>	<u>SANDY SHALE</u>	<u>126</u>	<u>136</u>
(distance) (direction) (Nearest Town)	<u>SHALE</u>	<u>136</u>	<u>200</u>
(3) Topography: <u>X</u> (Hilly) (Flat) (Level)	<u>SOFT SHALE</u>	<u>200</u>	<u>250</u>
(4) Purpose of Well: <u>DOMESTIC</u> (Domestic Irrigation Municipal, Industrial, Other)	<u>SANDY SHALE</u>	<u>250</u>	<u>260</u>
	<u>SHALE ST LIME ROCK</u>	<u>260</u>	<u>320</u>
	<u>SAND</u>	<u>320</u>	<u>350</u>
	<u>SANDY SHALE</u>	<u>350</u>	<u>360</u>


Information upon completion of well:

- (1) Diameter 4" inches.
- (2) Total Depth 360' feet.
- (3) Water Level 55' feet below top of ground.
- (4) Cased to 149, Size 4"
- (5) Screen: Size _____, Length _____
- (6) Were any formations sealed against pollution?
_____ yes, _____ no.

If YES depth of formation _____

Why _____

Drillers Remarks: _____

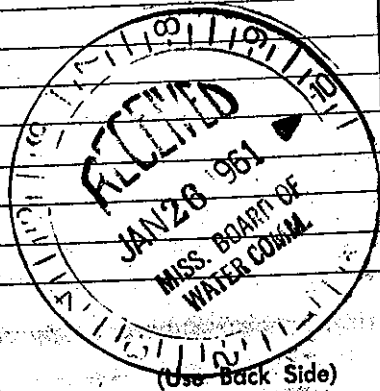

Well No. _____

Mail this copy to Board of Water Commissioners 429 Miss. St. Jackson, Miss.