

CLARKE  
C14  
9-11-62

MISSISSIPPI BOARD OF WATER COMMISSIONERS

**CODED**

WATER WELL DRILLERS LOG


Date: 9-11, 1962, Driller: McDonald - Hine County: Franklin  
(Name)

		Description & Color of Materials Sand, Clay, Red Clay, Shell, etc.	Thick- ness Feet	Depth Feet
(1) Owner of Land:	<u>J. E. Hagen</u> (Name)	<u>Sandy Clay</u>	<u>0</u>	<u>10</u>
	<u>Rt. #1 Meadion</u> (Address)	<u>Sand</u>	<u>10</u>	<u>34</u>
(2) Location:	<u>1/4</u> , <u>1/4</u> Sec. <u>4 N 6 E</u> T. R.	<u>Shale</u>	<u>34</u>	<u>58</u>
	<u>1</u> miles <u>W</u> of <u>Clarkdale</u> (distance) (direction) (Nearest Town)	<u>Rock</u>	<u>58</u>	<u>62</u>
(3) Topography:	(Hilly) (Flat) (Level)	<u>Clay</u>	<u>62</u>	<u>69</u>
(4) Purpose of Well:	<u>Domestic</u> (Domestic Irrigation Municipal, Industrial, Other)	<u>Sand</u>	<u>69</u>	<u>75</u>
		<u>Shale</u>	<u>75</u>	<u>100</u>
		<u>Rocky Sh. Shale</u>	<u>100</u>	<u>182</u>
		<u>Sand Shales</u>	<u>182</u>	<u>230</u>
		<u>Shales</u>	<u>230</u>	<u>240</u>
		<u>Sand</u>	<u>240</u>	<u>275</u>
		<u>Shale</u>	<u>275</u>	<u>392</u>
		<u>Rock</u>	<u>392</u>	<u>413</u>
		<u>Shale</u>	<u>413</u>	<u>457</u>
		<u>Rock</u>	<u>457</u>	<u>459</u>
		<u>Shale</u>	<u>459</u>	<u>700</u>
		<u>Sandy shale piece</u>	<u>700</u>	<u>760</u>

Information upon completion of well:

- (1) Diameter 4 inches.
- (2) Total Depth 760 feet.
- (3) Water Level 226 feet below top of ground.
- (4) Cased to 433, Size 4
- (5) Screen: Size ✓, Length ✓
- (6) Were any formations sealed against pollution?  
no.

**CODED**

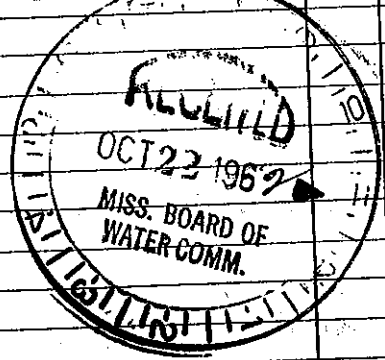

Well No.

(Use Back Side)

Mail this copy to Board of Water Commissioners 429 Miss. St. Jackson, Miss.