

CLARK  
 BC 15  
 11-11-64

WATER WELL DRILLERS LOG

**CODED**


Date: 11-11, 1964, Driller: M. Donald & Hill, Inc. County Clarke  
 (Name)

		Description & Color of Materials Sand, Clay, Red Clay, Shell, etc.	Thick- ness Feet	Depth Feet
(1) Owner of Land: <u>Charlie Mophus</u> (Name)				
<u>Rt. #1, Meridian, Miss.</u> (Address)		<u>Clay</u>	<u>0</u>	<u>20</u>
(2) Location: <u>1/4</u> , <u>1/4</u> , Sec. <u>7 T 4 R 16 E</u>		<u>CLAY ST SAND</u>	<u>20</u>	<u>40</u>
<u>15</u> miles <u>South</u> of <u>Meridian</u> (distance) (direction) (Nearest Town)		<u>SAND</u>	<u>40</u>	<u>76</u>
(3) Topography: <input checked="" type="checkbox"/> (Hilly) <input type="checkbox"/> (Flat) <input type="checkbox"/> (Level)				
(4) Purpose of Well: <u>Domestic</u> (Domestic Irrigation, Municipal, Industrial, Other)				

Information upon completion of well:

- (1) Diameter 2" WELL inches.
- (2) Total Depth 76' feet.
- (3) Water Level 65' feet below top of ground.
- (4) Cased to 69', Size 2" GALV
- (5) Screen: Size 2", Length 3'
- (6) Were any formations sealed against pollution?  
 yes,  no.

<b>CODED</b>
<b>STEEL</b>

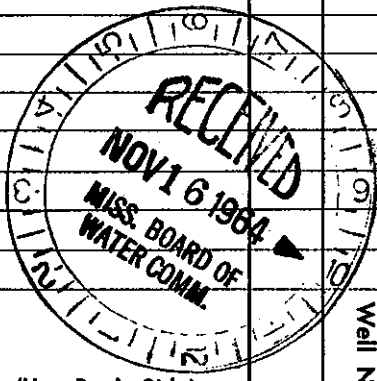

(Use Back Side)

Well No.

Mail this copy to Board of Water Commissioners 429 Miss. St. Jackson, Miss.