

# State Well Report

## Part 1

Mississippi Department of Environmental Quality  
Office of Land and Water Resources  
P.O. Box 10631  
Jackson, MS 39289-0631  
(601)961-5210  
(601)354-6938 (fax)

For Office Use Only:

Aquifer: \_\_\_\_\_  
Well #: C-23  
L. S. Elevation: \_\_\_\_\_  
E-log #: \_\_\_\_\_

County: CLARKE  
Permit #: \_\_\_\_\_  
Driller: McDONALD-Hill, INC  
Date drilling completed: \_\_\_\_\_

State Law requires that this report be prepared by the driller in detail and filed with the Department within 30 days of completion of drilling of the well.

Well Owner Information	Well Location
Owner Name: <u>Gene Moffett</u>	Latitude: _____ Longitude: _____
Mailing Address: <u>7430 CR 450</u> <u>Meridian, MS 39301</u>	Method of Lat/Long (circle one): Conventional Survey, USGS quad, Hand-held GPS, Survey-grade GPS
City: _____ State: _____ Zip Code: _____	1/4 _____ 1/4 Sec <u>2</u> Twn <u>4N</u> Rng <u>16E</u>
Telephone No. ( <u>601</u> ) <u>693-2115</u>	Distance <u>10</u> Miles Direction <u>South</u> of Nearest Town <u>Meridian</u>

**Well Data**

Purpose of Well (circle one) Home Industrial Public Supply Irrigation Fish Culture Other: \_\_\_\_\_

Date well drilling started: 3-16-07 Date well drilling completed: 3-19-07

If flowing, method of flow regulation: Valve \_\_\_\_\_ Other (describe) \_\_\_\_\_

Static Water Level: 100' feet above or below (circle one) land surface Date measured: 3-19-07

Method of Measurement (circle one) steel tape electric tape air line other: \_\_\_\_\_

Hole depth: 350' Well depth: 350' Well grouted to a depth of 10 feet

Type of grout (circle one): Cement Bentonite Mix

Casing length: 330 feet Casing diameter: 4" inches Type of casing: PVC

Screen length: 30 feet Screen diameter: 2" inches Type of screen: PVC

Screen slot size: #008 inches Setting depth: From 320' feet to 350' feet

Type of completion (circle all applicable): Gravel packed Underreamed Telescoped Open hole Natural Development

Other (describe): \_\_\_\_\_

Top of lap pipe or reduction in casing: 200' feet. If telescoped or more than one screen, describe on back of page


Logs run (circle all applicable): No log run Electric Gamma Ray Density Sonic Neutron Other: \_\_\_\_\_

Name of organization running log(s): \_\_\_\_\_

I certify that the well was drilled, constructed, and completed in accordance with all applicable requirements of the Mississippi Department of Environmental Quality and/or the Mississippi Department of Health regulations and state laws.

McDONALD-Hill, INC #0-8 Harold Hill  
Print Name of Water Well Contractor and License No. Signature of Water Well Contractor


If well telescopes please sketch below and show depths.

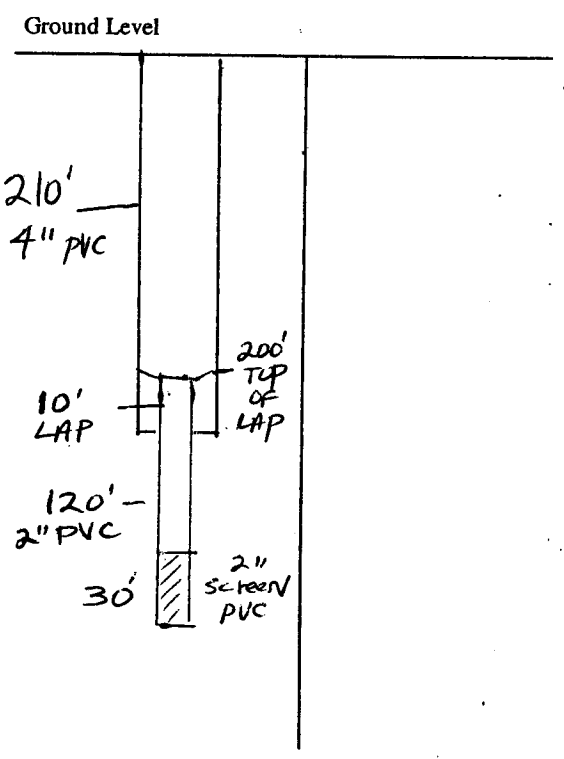

Description of Formations Encountered	From	To
SAND + CLAY	0	20
SAND + shale	20	100
SANDY shale	100	130
SHALE + st SAND	130	150
SHALE	150	235
ROCK	235	238
SHALE	238	310
SANDY st.	310	350

If more than one screen, show location of each on sketch

Sketch the property layout and include the following: 1) the well location; 2) any permanent structures on the property that may aid in locating the well; 3) any roads, power lines, or other items that may aid in locating the property and the well; 4) indicate direction.

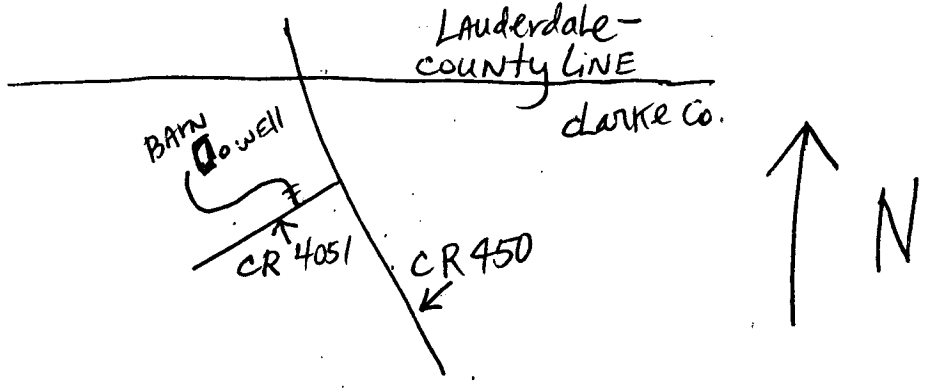

Landowner Name: Gene Moffelt

Harold Hill  
Signature of Water Well Contractor

RECEIVED  
APR 16 1987  
WATER

# STATE WELL REPORT

## Part 2

**Pump Installer's Completion Report**  
 Mississippi Department of Environmental Quality  
 Office of Land and Water Resources  
 P.O. Box 10631  
 Jackson, MS 39289-0631  
 (601)961-5210  
 (601)354-6938 (fax)

For Office Use Only:

Aquifer: \_\_\_\_\_

Well #: C-23

Elevation: \_\_\_\_\_

County: CLARKE

Permit #: \_\_\_\_\_

Driller: McDONALD-HILL, INC

Date completed: 3-23-07

This report should be prepared by the pump installer in detail and filed with the Department within 30 days of the installation of pump.

Well Owner Information	Well Location
Owner Name: <u>Gene Moffett</u>	Latitude: _____ Longitude: _____
Mailing Address: <u>7430 CR 450</u> <u>Meridian, Ms. 39301</u>	Method of Lat/Long (circle one): Conventional Survey, USGS quad, Hand-held GPS, Survey-grade GPS
City State Zip Code	_____ 1/4 _____ 1/4 Sec <u>2</u> Twn <u>4N</u> Rng <u>16E</u>
Telephone No. <u>601, 693-2115</u>	Distance Direction Nearest Town <u>10</u> Miles <u>South</u> of <u>Meridian, Ms.</u>

Pump Type Circle one	Power Type Circle one
Air Lift Jet <input type="radio"/> <u>Submersible</u>	Diesel Engine Gasoline Engine Natural Gas
Bucket Piston <input type="radio"/> Turbine <input type="radio"/>	<u>Electric Motor</u> Hand Tractor PTO
Centrifugal Rotary <input type="radio"/> Flowing Well <input type="radio"/>	Windmill Other (specify): _____
Other (specify): _____	Horse Power Rating of Motor: <u>3/4 HP</u>
Date Pump Installed: <u>3-23-07</u>	Setting Depth: <u>180'</u> feet
Rated Pump Capacity: <u>7</u> Gallons Per Minute	Number of Stages: <u>14</u>

Pump Test Data	Method of Measuring Water Level Circle one
Date Well Tested: <u>3-23-07</u>	Air Line Electric Measuring Line <u>Steel Tape</u>
Static Water Level (A): <u>100</u> Feet Below Land Surface	Other (specify): _____
Pumping Water Level (B): <u>122</u> Feet Below Land Surface	For flowing well, measured shut in head: _____ feet
Drawdown [(B) - (A)]: <u>22</u> Feet Below Land Surface	Well yielded <u>20</u> GPM with a drawdown of
Test Pumping Rate: <u>8</u> Gallons Per Minute	<u>22</u> feet after <u>3</u> hours of pumping
Duration of Pump Test (minimum 4 hours): <u>4</u> hours	

I HEREBY CERTIFY that the above statements are true to the best of my knowledge.

Harold Hill

Print Name of Pump Installer and License No. (if applicable)

Harold Hill

Signature of Pump Installer