

CLARKE

D 2

12-31-61

Date: 12-31, 1961, Driller: Peoples & Rutledge County, Clarke

(Name)

(1) Owner of Land: Earl Martin
(Name)

(Address)

(2) Location: 1/4, 1/4, Sec. 4 T4R17
off 4 miles South, of Causeville
(distance) (direction) (Nearest Town)

(3) Topography: Hilly
(Hilly) (Flat) (Level)

(4) Purpose of Well: Domestic Irrigation
(Domestic Irrigation
Municipal, Industrial, Other)

| Description & Color of Materials Sand, Clay, Red Clay, Shell, etc. | Thick- ness Feet | Depth Feet |
|-----------------------------------------------------------------------|------------------------|---------------|
| Red Sandy Clay | 21 | 21 |
| Yellow Sand | 44 | 65 |
| Sand Rock | 2 | 67 |
| Gray Sandy shale | 59 | 126 |
| Gray Sandy shale and small sand streaks | 68 | 194 |
| Shale | 51 | 245 |
| Hard Rock | 3 | 248 |
| Gray Sandy shale and Lignite streaks | 130 | 378 |
| Gray Sandy shale | 88 | 458 |
| Sand Rock | 1 | 459 |
| Gray Sand | 8 | 467 |
| Gray Sandy shale | 13 | 480 |
| Fine Gray Sand | 34 | 514 |

Information upon completion of well:

(1) Diameter 4 inches.

(2) Total Depth 514 feet.

(3) Water Level 163' feet below top of ground.

(4) Cased to 232', Size 4"

(5) Screen: Size None, Length 0


(6) Were any formations sealed against pollution?
 yes, no.

If YES depth of formation 65'

Why High iron content

Drillers Remarks:

B/A
C/D
/

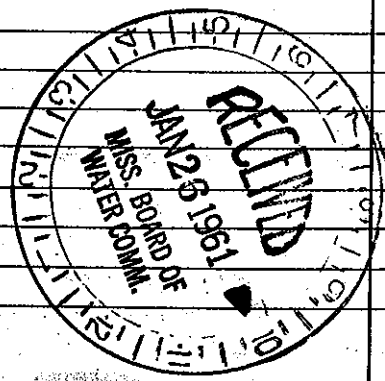

(Use Back Side)

Well No.

Mail this copy to Board of Water Commissioners 429 Miss. St. Jackson, Miss.