

CLARKE
3 D3
9-67

MISSISSIPPI
BOARD OF WATER COMMISSIONERS
416 North State Street
Jackson, Mississippi 39201

WATER WELL DRILLERS LOG

Mc P

date well completed 1967 McDONALD + NILL firm name CLARK county well located

LANDOWNER: Clyde DEARMAN
ENERGY MISS
(mailing address)


description of formations encountered	from	to
<u>sand</u>	<u>0</u>	<u>40</u>
<u>Clay & sand</u>	<u>40</u>	<u>70</u>
<u>shale</u>	<u>70</u>	<u>100</u>
<u>sand & shale</u>	<u>100</u>	<u>135</u>
<u>shale</u>	<u>135</u>	<u>170</u>
<u>sandy soft shale</u>	<u>170</u>	<u>230</u>
<u>shale</u>	<u>230</u>	<u>310</u>
<u>sandy shale sand</u>	<u>310</u>	<u>340</u>
<u>lady shale</u>	<u>340</u>	<u>380</u>

WELL LOCATION:
sec. 22 T 4 N R 17 E
ENERGY miles (distance) of (direction) of (nearest town)

WELL PURPOSE: HOME
(home, irrigation, municipal, industrial)

WELL COMPLETION DATA:

- (1) diameter (inches) 4" WELL
- (2) total depth (feet) 380'
- (3) static water level (feet) 150 below top of ground.
- (4) casing Galv, 252' (material), (depth)
4" (size) if telescope see back.
- (5) screen NO (length), (depth to top)
(size) (material)
- (6) pump 3/4 SUB, 10 (HP), (yield gpm)
320 (type power)
- (7) electric log NO (yes or no)
NO (organization running log)
- (8) how well bottom plugged OPEN

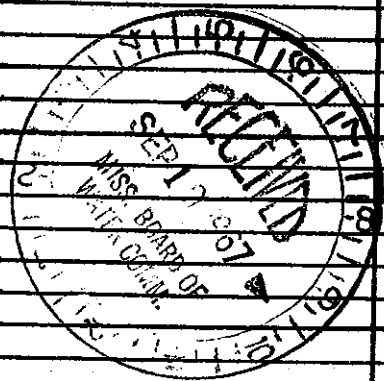

DRILLERS REMARKS: