

CLARKE
3 D4
9-67

MISSISSIPPI
BOARD OF WATER COMMISSIONERS
416 North State Street
Jackson, Mississippi 39201

WATER WELL DRILLERS LOG

date well completed 9-15-67 firm name McDONALD + HILL county well located CLARK

LANDOWNER: Billy Irby
ENERGY MISS

(mailing address)

WELL LOCATION:

sec. 15-T-4N R. 17-E
ENERGY


(distance) miles (direction) of (nearest town)

WELL PURPOSE: HOME
(home, irrigation, municipal, industrial)

WELL COMPLETION DATA:

- (1) diameter (inches) 4" WELL
- (2) total depth (feet) 415'
- (3) static water level (feet) 160' below top of ground.
- (4) casing BLACK, 260',
(material) (depth)
4"
(size) If telescope see back.
- (5) screen X, X
(length) (depth to top)
X, X
(size) (material)
- (6) pump 3/4 SUB,
(HP) (yield gpm)
220
(type power)
- (7) electric log NO
(yes or no)
NO
(organization running log)
- (8) how well bottom plugged OPEN

description of formations encountered	from to	
Clay	0	12
Sand & Clay	12	70
Shale	70	120
Sand & Shale	120	146
Shale	146	210
Soft Shale	210	235
Shale	235	262
Rock	262	265
Shale	265	300
Shale & Signite	300	362
fine sand	362	380
Soft Shale	380	392
Sand	392	415

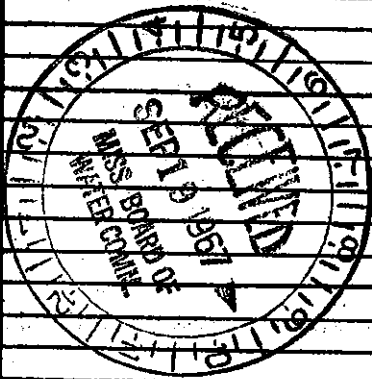

DRILLERS REMARKS: