

CLARKE MISSISSIPPI BOARD OF WATER COMMISSIONERS

D5

2-25-66

WATER WELL DRILLERS LOG


Date: 7-23, 1966, Driller: M^cDonald Hill County Clark
(Name)

(1) Owner of Land: JACKIE IRBY
(Name)
R#7 MERIDIAN
(Address)
"On Causeway to Energy
(2) Location: 1/4, 1/4, Sec 10 NE
10 4N 17E
16 miles S.EAST, of MERIDIAN
(distance) (direction) (Nearest Town)
(3) Topography: X
(Hilly) (Flat) (Level)
(4) Purpose of Well: DOMESTIC
(Domestic Irrigation
Municipal, Industrial, Other)

Description & Color of Materials Sand, Clay, Red Clay, Shell, etc.	Thick- ness Feet	Depth Feet
CLAY	0	18
Sand & Clay	18	41
SAND ROCK	41	72
Sand & Clay	42	103
Rock	103	105
Sand	105	190
Sand & Clay	190	218
Sand	218	230

Information upon completion of well:

(1) Diameter: 3 3/8 inches. TEST HOLE
(2) Total Depth: 230' feet.
(3) Water Level: 168' feet below top of ground.
(4) Cased to: 220', Size: 2"
(5) Screen: Size: 2", Length: 5' STEEL
(6) Were any formations sealed against pollution?
_____ yes, _____ no.

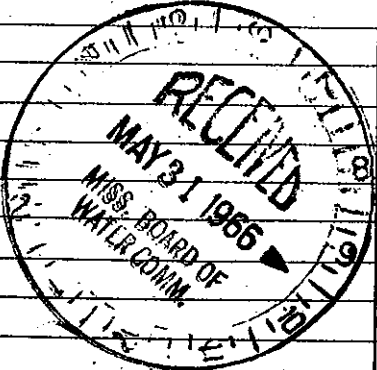

If YES depth of formation _____
Why _____
Drillers Remarks: _____

Well No.

(Use Back Side)

Mail this copy to Board of Water Commissioners 429 Miss. St. Jackson, Miss.