

MISSISSIPPI BOARD OF WATER COMMISSIONERS

CLARKE

P

6

D6

WATER WELL DRILLERS LOG

7-63

Date: July, 1963, Driller: Peoples Drilling Co. County: Clarke
(Name)

(1) Owner of Land:	Description & Color of Materials Sand, Clay, Red Clay, Shell, etc.	Thick- ness Feet	Depth Feet
(Name) Donald	Red Sand	12	12
(Address) Energy, Miss	Red sand + clay		
(2) Location: 1/4, 1/4, Sec. 22 T. 4N R. 17E	shale	30	42
(distance) 5 miles S, of Coatesville	yellow sandy		
(direction) (Nearest town)	clay + sand shale	52	94
(3) Topography: Hilly	yellow sand	18	112
(Hilly) (Flat) (Level)			
(4) Purpose of Well: Domestic			
(Domestic Irrigation Municipal, Industrial, Other)			

Information upon completion of well:

(1) Diameter 2 inches.

(2) Total Depth 112 feet.

(3) Water Level 82 feet below top of ground.

(4) Cased to 105', Size 2"


(5) Screen: Size 2", Length 6'

(6) Were any formations sealed against pollution?
 yes, no.

If YES depth of formation _____

Why _____

Drillers Remarks: _____

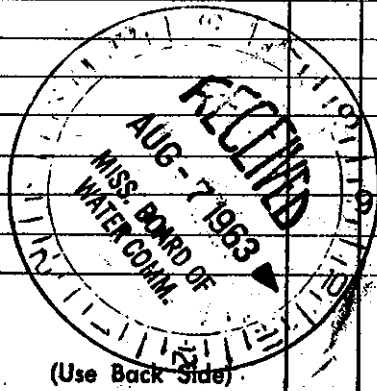

Well No.

Mail this copy to Board of Water Commissioners 429 Miss. St. Jackson, Miss