

Clarke
3 E 3
9-66

Shirley

P

MISSISSIPPI BOARD OF WATER COMMISSIONERS

WATER WELL DRILLERS LOG

Date: 9-22, 1966, Driller: M^r. Donald L Hill, Jr County CLARKE
(When well drilled) (Name) (Where well is located)

(1) Owner of Land: J. D. SHIRLEY
(Name)
Rt. # 7, Meridian
(Address)
 (2) Location: SW 1/4, NW 1/4, Sec. 5 T4 R18
(distance) (direction) (Nearest Town)
 (3) Topography: X
(Hilly) (Flat) (Level)
 (4) Purpose of Well: DOMESTIC
(Domestic Irrigation Municipal, Industrial, Other)

Description & Color of Materials Sand, Clay, Red Clay, Shell, etc.	Thick- ness Feet	Depth Feet
CLAY	25	25
SAND CLAY	15	40
SAND ST CLAY	70	110
SHALE	26	136
SAND	6	142
ROCK	6	148
SHALE	92	240
SANDY	10	250
SHALE	160	410
SAND	20	430

Information upon completion of well:

(1) Diameter 4" WELL inches.

(2) Total Depth 430' feet.

(3) Water Level 160' feet below top of ground.

(4) Cased to 168', Size 4"

(5) Screen: Size None, Length None

(6) Were any formations sealed against pollution?
 _____ yes, X no.

If YES depth of formation _____


Why _____

Drillers Remarks: _____

Yield in gpm: 30

Size pump: 1/2 hp sub pump

Type power: _____

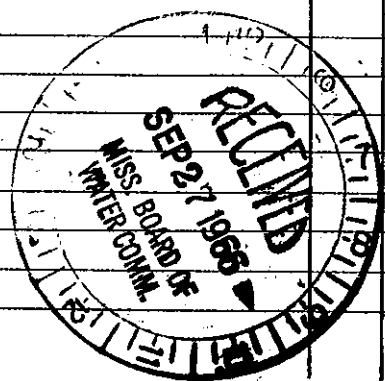

Mail this copy to Board of Water Commissioners 429 Miss. St. Jackson, Miss.