


CLARKE

E 4

7-19-66

MISSISSIPPI BOARD OF WATER COMMISSIONERS

WATER WELL DRILLERS LOG

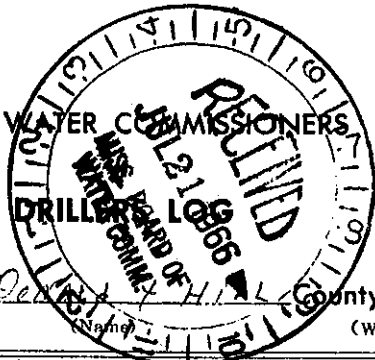

Date: 7-19, 1966, Driller: Mc... County LAUD

(1) Owner of Land: DAVE SMITH (Name)
RT 7 MDN (Address)
(2) Location: 1/4, 1/4, Sec. 7 4N 18E T. R.
1 miles East of South (distance) (direction) (nearest Town)
(3) Topography: HILLY (Hilly) (Flat) (Level)
(4) Purpose of Well: DOMESTIC (Domestic Irrigation Municipal, Industrial, Other)

Table with 4 columns: Description & Color of Materials, Thickness Feet, Depth Feet. Rows include SANDY CLAY, Big BW Shale, SANDY CLAY, H SHALE, SANDY SHALE, M TO SOFT SHALE, H SHALE BW, SOFT SHALE, ROCK, SHALE-M- Big SW, ROCK, SANDY LIG, SHALE SOFT TO M, M TO SOFT SHALE, SANDY SHALE SOFT.

Information upon completion of well:

(1) Diameter 4 inches.
(2) Total Depth 430 feet.
(3) Water Level 175 feet below top of ground.
(4) Cased to 252, Size 4
(5) Screen: Size, Length
(6) Were any formations sealed against pollution?
yes, no.
If YES depth of formation
Why
Drillers Remarks:
Yield in gpm:
Size pump:
Type power:

Mail this copy to Board of Water Commissioners 429 Miss. St. Jackson, Miss.