

P

Clarke  
S F I  
5-67

MISSISSIPPI  
BOARD OF WATER COMMISSIONERS  
416 North State Street  
Jackson, Mississippi 39201

WATER WELL DRILLERS LOG

5-10-67 19 McDONALD HILL CLARK  
date well completed firm name county well located

LANDOWNER: TERRY BECKMAN

QUITMAN

(mailing address)

WELL LOCATION:


sec 36 T. 3 N R. 14 E  
S W  
5 miles WEST of QUITMAN  
(distance) (direction) (nearest town)

WELL PURPOSE: HOME  
(home, irrigation, municipal, industrial)

WELL COMPLETION DATA:

- (1) diameter (inches) 3 7/8 TEST HOLE
- (2) total depth (feet) 220'
- (3) static water level (feet) 20' below top of ground.
- (4) casing Galv 2 1/2" 215'  
(material) (depth)
- No if telescope see back.  
(size)
- (5) screen 6' 2 1/2" 215'  
(length) (depth to top)
- 2" BRASS  
(size) (material)
- (6) pump 3/4 JET 6  
(HP) (yield gpm)
- 230  
(type power)
- (7) electric log NO  
(yes or no)
- NO  
(organization running log)
- (8) how well bottom plugged VALUE

| Description of formations encountered | from | to  |
|---------------------------------------|------|-----|
| CLAY                                  | 0    | 8   |
| SAND                                  | 8    | 14  |
| SAND ST SHALE                         | 14   | 35  |
| SHALE                                 | 35   | 75  |
| LIME ROCK ST SHALE                    | 75   | 135 |
| SHALE                                 | 135  | 155 |
| FINE SAND                             | 155  | 195 |
| SAND 10-12                            | 195  | 220 |

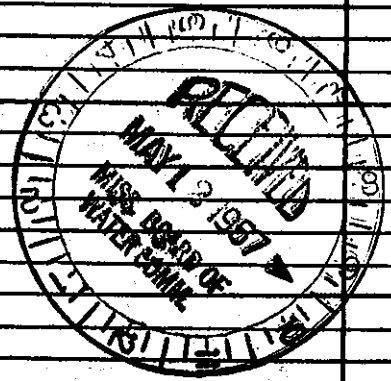

DRILLERS REMARKS: