

CLARKE MISSISSIPPI BOARD OF WATER COMMISSIONERS

6 F6

WATER WELL DRILLERS LOG

B-302 P

9-18-61

Date: 9-18, 1961, Driller: Peoples & Rutledge County: Clarke

(Name)

(1) Owner of Land: <u>Marion H Jordan</u> (Name)	Description & Color of Materials Sand, Clay, Red Clay, Shell, etc.	Thick- ness Feet	Depth Feet
<u>Box 132 Rt. 2 Enterprise, Miss. Ukiah</u> (Address)	<u>Yellow Sandy Clay</u>	<u>40</u>	<u>40</u>
(2) Location: <u>1/4, 1/4, Sec 10 T. R. 3N 14E</u>	<u>Blue Clay</u>	<u>43</u>	<u>83</u>
<u>2 miles south</u> of <u>Enterprise</u> (distance) (direction) (Nearest Town)	<u>Blue Sandy Clay + fine sand streaks</u>	<u>32</u>	<u>115</u>
(3) Topography: <u>Hilly</u> (Hilly) (Flat) (Level)	<u>Fine White Sand</u>	<u>15</u>	<u>130</u>
(4) Purpose of Well: <u>Domestic</u> (Domestic Irrigation Municipal, Industrial, Other)			


Information upon completion of well:

- (1) Diameter 2 inches.
- (2) Total Depth 130 feet.
- (3) Water Level 80 feet below top of ground.
- (4) Cased to 130, Size 2"
- (5) Screen: Size 8, Length 6'
- (6) Were any formations sealed against pollution?
_____ yes, _____ no.

If YES depth of formation _____

Why _____

Drillers Remarks: _____

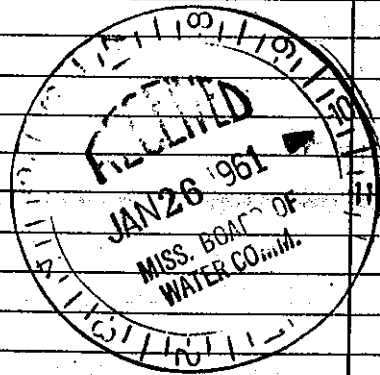

Well No.

(Use Back Side)

Mail this copy to Board of Water Commissioners 429 Miss. St. Jackson, Miss.