

CLARKE MISSISSIPPI BOARD OF WATER COMMISSIONERS

6 F7
6-62

WATER WELL DRILLERS LOG

CODED

Date: June, 1962, Driller: Peepert & Rullledge County Clarke
(Name)

(1) Owner of Land: Jim Lewis
(Name)
Patchita, Miss
(Address)

(2) Location: 1/4, 1/4, Sec. 21 3N14E T. R
3 1/2 miles NE, of Patchita
(distance) (direction) (Nearest Town)

(3) Topography: Flat & hilly
(Hilly) (Flat) (Level)

(4) Purpose of Well: Domestic
(Domestic Irrigation
Municipal, Industrial, Other)

Description & Color of Materials Sand, Clay, Red Clay, Shell, etc.	Thick- ness Feet	Dep'th Feet
top to yellow sandy clay	21	21
gray shale & small gray sand streak	24	45
gray sand & small clay streak	33	78

Information upon completion of well:

(1) Diameter 2" inches.

(2) Total Depth 75 feet.

(3) Water Level 30 feet below top of ground.

(4) Cased to 69', Size 2"

(5) Screen: Size 2", Length 6'


(6) Were any formations sealed against pollution?
yes, no.

If YES depth of formation _____

Why _____

Drillers Remarks: _____

CODED

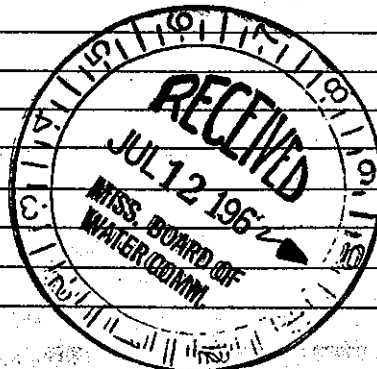

(Use Back Side)

Well No.

Mail this copy to Board of Water Commissioners 429 Miss. St. Jackson, Miss.