

6 **CLARKE** **F 9** **WATER WELL DRILLERS LOG**

Date: Jan 1-64, 1964, Driller: Peoples Drilling County Clarke<sup>P</sup>  
(Name)

(1) Owner of Land: <u>Noah Kidd</u> <small>(Name)</small>	Description & Color of Materials Sand, Clay, Red Clay, Shell, etc.	Thick- ness Feet	Depth Feet
<u>Enterprise, Miss</u> <small>(Address)</small>			
(2) Location: <u>3/4</u> , <u>3/4</u> , Sec. <u>12</u> T. <u>R.</u>			
<u>5</u> miles <u>S</u> of <u>Enterprise</u> <small>(distance) (direction) (Nearest Town)</small>			
(3) Topography: <u>Hilly</u> <small>(Hilly) (Flat) (Level)</small>	0-21 Red clay		
(4) Purpose of Well: <u>Domestic</u> <small>(Domestic Irrigation Municipal, Industrial, Other)</small>	21-42 yellow sand		
	42-84 Blue Marl		
	84-105 lime		
	105-147 Grey Shale		
	147-294 Grey Sand		
	294-325 Grey Shale		
	325-336 Rock		
	336-483 Grey Shale		
	483-514 Marl		
	514-556 Grey Sandy Shale		

Information upon completion of well:

(1) Diameter 4" inches.

(2) Total Depth 556' feet.

(3) Water Level 220' feet below top of ground.

(4) Cased to 336, Size 4"


(5) Screen: Size \_\_\_\_\_, Length \_\_\_\_\_

(6) Were any formations sealed against pollution?  
 yes,  no.

If YES depth of formation \_\_\_\_\_

Why \_\_\_\_\_

Drillers Remarks: \_\_\_\_\_

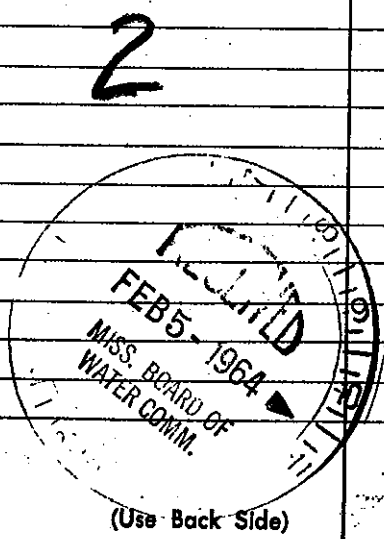

Well No.

Mail this copy to Board of Water Commissioners 429 Miss. St. Jackson, Miss