

CLARKE

MISSISSIPPI BOARD OF WATER COMMISSIONERS

F13

4-65

WATER WELL DRILLERS LOG

Date: April, 1965, Driller: Peoples Drilling Co. County: Clarke

(Name)

(1) Owner of Land: Clarence Kidd (Name) Enterprise, Miss (Address)

Description & Color of Materials Sand, Clay, Red Clay, Shell, etc.

Thick-ness Feet

Depth Feet

yellow sand clay  
yellow sand

21 21  
24 45

(2) Location: 1/4, 1/4, Sec 12 T. R. 3N 14E  
4 miles S of Enterprise (distance) (direction) (Nearest Town)

(3) Topography: Hilly (Hilly) (Flat) (Level)

(4) Purpose of Well: Home (Domestic Irrigation Municipal, Industrial, Other)

Information upon completion of well:

(1) Diameter 2 inches.

(2) Total Depth 45 feet.

(3) Water Level 20 feet below top of ground.

(4) Cased to 40', Size 2"

(5) Screen: Size 2", Length 6'


(6) Were any formations sealed against pollution?

yes, no. (checked no)

If YES depth of formation

Why

Drillers Remarks:

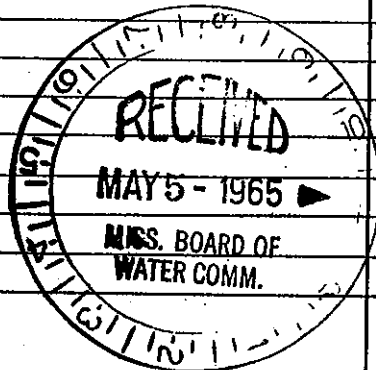

(Use Back Side)

Well No.

Mail this copy to Board of Water Commissioners 429 Miss. St. Jackson, Miss.