

CLARKE
F 18
4-68

MISSISSIPPI
BOARD OF WATER COMMISSIONERS
416 North State Street
Jackson, Mississippi 39201

CODED

WATER WELL DRILLERS LOG

4.3.68 19 McDonald + Hill CLARK
date well completed firm name county well located

LANDOWNER: DELMBA SMITH

R#2 ENTERPRISE

(mailing address)

WELL LOCATION:

sec. 3 T. 3 N R. 14 E
S W
3 miles SOUTH ENTERPRISE
(distance) (direction) of (nearest town)

WELL PURPOSE: HOME
(home, irrigation, municipal, industrial)

WELL COMPLETION DATA:


- (1) diameter (inches) 4" WELL
- (2) total depth (feet) 550'
- (3) static water level (feet) 165' below above top of ground.
- (4) casing BLACK 315'
(material) (depth)
4" If telescope see back.
(size)
- (5) screen X/O X/O
(length) (depth to top)
X/O 113
(size) (material)
- (6) pump 3/4 10
(HP) (yield gpm)
220
(type power)
- (7) electric log NO
(yes or no)
NO
(organization running log)
- (8) how well bottom plugged OPEN

description of formations encountered

from to

Clay	0	18
Sand	18	38
Shale	38	60
Shale Lt Rock	60	135
Sandy	135	160
Sand	160	285
Shale	285	318
Shale Lt Rock	318	350
Green Sand	350	360
Sandy	360	380
Shale Lt Rock	380	480
Shale	480	500
Sand	500	525
Sandy	525	550

CODED

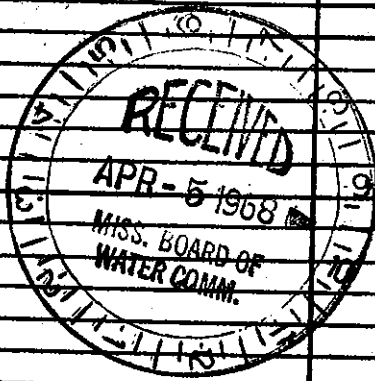

DRILLERS REMARKS: