

Clarke  
F 22

MISSISSIPPI BOARD OF WATER COMMISSIONERS

7-8-62

WATER WELL DRILLERS LOG

Date: 7-8, 1962, Driller: Mr. Donald Hill County Clarke

(Name)

(1) Owner of Land: B. W. Hanson

(Name)

Rt. #2 Enterprise, Miss

(Address)

(2) Location: 1/4, 3N/4, Sec. T R/E

3 miles South, of Enterprise

(distance)

(direction)

(Nearest town)

(3) Topography: ✓

(Hilly)

(Flat)

(Level)

(4) Purpose of Well: Domestic

(Domestic Irrigation  
Municipal, Industrial, Other)

Description & Color of Materials  
Sand, Clay, Red Clay, Shell, etc.

Thick-  
ness  
Feet

Depth  
Feet

<u>Sandy clay</u>	<u>0</u>	<u>12</u>
<u>Line of shale st.</u>	<u>12</u>	<u>57</u>
<u>Shells</u>	<u>57</u>	<u>65</u>
<u>Line of sand st.</u>	<u>65</u>	<u>105</u>
<u>Fine sand</u>	<u>105</u>	<u>127</u>
<u>Shale</u>	<u>127</u>	<u>128</u>
<u>Fine sand</u>	<u>128</u>	<u>170</u>
<u>Coarse sand</u>	<u>170</u>	<u>200</u>

Information upon completion of well:

(1) Diameter 2" inches.

(2) Total Depth 200 feet.

(3) Water Level 120 feet below top of ground.

(4) Cased to 190, Size 2"

(5) Screen: Size 2", Length 5'


(6) Were any formations sealed against pollution?

yes, ✓ no.

If YES depth of formation \_\_\_\_\_

Why \_\_\_\_\_

Drillers Remarks: \_\_\_\_\_

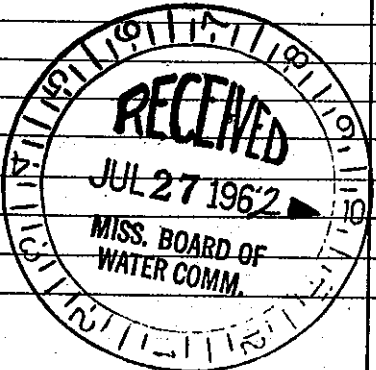

(Use Back Side)

Well No. \_\_\_\_\_

Mail this copy to Board of Water Commissioners 429 Miss. St. Jackson, Miss

CODED

CODED