

Clarke
F 23

MISSISSIPPI BOARD OF WATER COMMISSIONERS

WATER WELL DRILLERS LOG

1-28-62

Date: 1-28, 1962, Driller: McDONALD & HILL, Inc.

P. O. BOX 81

MISSISSIPPI

CODED

(1) Owner of Land: B.J. Walker
(Name)

Rose Hill

(Address) 30 3N 14E

(2) Location: 1/4, 1/4, Sec. T. R.

15 miles SW, of Enterprise
(distance) (direction) (Nearest Town)

(3) Topography: (Hilly) (Flat) (Level)

(4) Purpose of Well: Domestic
(Domestic Irrigation, Municipal, Industrial, Other)

Description & Color of Materials Sand, Clay, Red Clay, Shell, etc.	Thick- ness Feet	Depth Feet
<u>Clay</u>	<u>0</u>	<u>10</u>
<u>Sand</u>	<u>10</u>	<u>54</u>
<u>B. Shale</u>	<u>54</u>	<u>86</u>
<u>fine Sand</u>	<u>86</u>	<u>95</u>
<u>B. Shale</u>	<u>95</u>	<u>100</u>

Information upon completion of well:

(1) Diameter 2 inches.

(2) Total Depth 55 feet.

(3) Water Level _____ feet below top of ground.

(4) Cased to 47, Size 2

(5) Screen: Size # 12, Length 5


(6) Were any formations sealed against pollution?
_____ yes, no.

If YES, depth of formation _____

Why _____

Drillers Remarks: _____

CODED

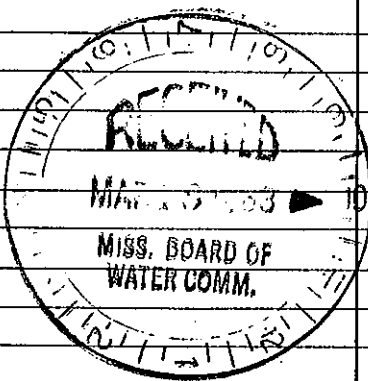

(Use Back Side)

Well No.

Mail this copy to Board of Water Commissioners 429 Miss. St. Jackson, Miss.