

CLARKE
AF 26
6-65

MISSISSIPPI BOARD OF WATER COMMISSIONERS

WATER WELL DRILLERS LOG

CODED

Date: June, 1965, Driller: Peoples Drilling County Clarke
(Name)

(1) Owner of Land:	Description & Color of Materials Sand, Clay, Red Clay, Shell, etc.	Thick- ness Feet	Depth Feet
<u>T. M. Kidd</u> (Name) <u>Enterprise</u> (Address)	<u>Red sandy clay</u> <u>+ small sand beach</u>	<u>35</u>	<u>35</u>
(2) Location: <u>1/4</u> , <u>1/4</u> , Sec. <u>9 T. 3 R. 14</u> <u>community of Pine Hill</u> (distance) (direction) (Nearest Town)	<u>yellow sand +</u> <u>clay streak</u> <u>blue wash</u>	<u>17</u>	<u>52</u>
(3) Topography: <u>Hilly</u> (Hilly) (Flat) (Level)			
(4) Purpose of Well: <u>Home</u> (Domestic Irrigation, Municipal, Industrial, Other)			

CODED


Information upon completion of well:

- (1) Diameter 2 inches.
- (2) Total Depth 52 feet.
- (3) Water Level 30 feet below top of ground.
- (4) Cased to 46', Size 2"
- (5) Screen: Size 2", Length 6'
- (6) Were any formations sealed against pollution?
_____ yes, _____ no.

If YES depth of formation _____

Why _____

Drillers Remarks: _____

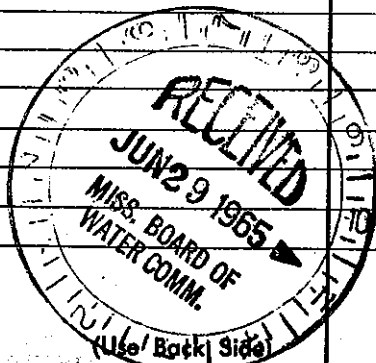

Well No. _____

Mail this copy to Board of Water Commissioners 429 Miss. St. Jackson, Mis: