

CLARKE MISSISSIPPI BOARD OF WATER COMMISSIONERS

3 G4
6-64

WATER WELL DRILLERS LOG

Date: June, 1964, Driller: Peoples Drilling Co. County, Clarke

(Name)

(1) Owner of Land: <u>Cocaine Plant</u> (Name)	Description & Color of Materials Sand, Clay, Red Clay, Shell, etc.	Thick- ness Feet	Depth Feet
<u>Stonewall, Miss.</u> (Address)	<u>Yellow to white sand</u>	48	48
(2) Location: <u>1/4, 1/4, Sec. 27</u> <u>3N 15E</u> T. R.	<u>Blue marl</u>	57	105
<u>2</u> miles <u>S</u> of <u>Stonewall</u> (distance) (direction) (Nearest Town)	<u>Green sand + chert</u>	15	120
(3) Topography: <u>Flat</u> (Hilly) (Flat) (Level)	<u>Blue marl + rock</u>	111	231
(4) Purpose of Well: <u>Industrial</u> (Domestic Irrigation Municipal, Industrial, Other)	<u>Coarse shale + sandy shale</u>	14	245
	<u>White sand + shale streaks</u>	28	273


Information upon completion of well:

- (1) Diameter 2 inches.
- (2) Total Depth 273 feet.
- (3) Water Level Flow feet below top of ground.
- (4) Cased to 252', Size 2"
- (5) Screen: Size 2", Length 6'
- (6) Were any formations sealed against pollution?
_____ yes, _____ no.

If YES depth of formation _____

Why _____

Drillers Remarks: _____

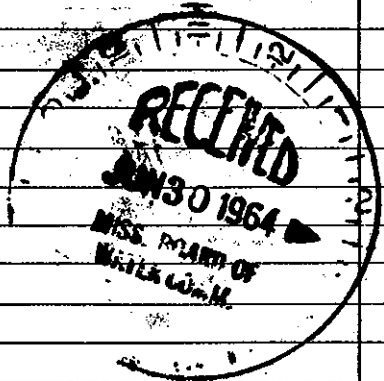

(Use Back Side)

Well No.

Mail this copy to Board of Water Commissioners 429 Miss. St. Jackson, Miss.