

CLARKE

MISSISSIPPI BOARD OF WATER COMMISSIONERS

3 G5
4-65

WATER WELL DRILLERS LOG

Date: April, 1965, Driller: Peoples Drilling Co. County: Clarke

(Name)

(1) Owner of Land:	Description & Color of Materials Sand, Clay, Red Clay, Shell, etc.	Thick- ness Feet	Depth Feet
American Concrete Well	White sand	57	57
(Name)	Blue marl & rock	48	105
Stonewall	Blue sand & chert	21	126
(Address)	Blue marl & rock	105	231
(2) Location: 1/4, 1/4, Sec 27 3N 15E T. R.	Blue sandy shale		
2 miles S, of Stonewall	& white sand & blue	21	252
(distance) (direction) (Nearest Town)			
(3) Topography: Flat			
(Hilly) (Flat) (Level)			
(4) Purpose of Well:			
(Domestic Irrigation Municipal, Industrial, Other)			


Information upon completion of well:

- (1) Diameter: 2 inches.
- (2) Total Depth: 252 feet.
- (3) Water Level: 7 feet below top of ground.
- (4) Cased to: 246", Size 2"
- (5) Screen: Size 2", Length 6'
- (6) Were any formations sealed against pollution?
yes, no.

If YES depth of formation

Why

Drillers Remarks:

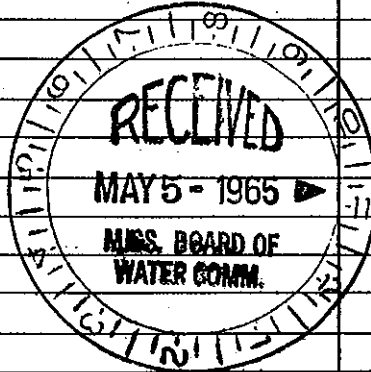

(Use Back Side)

Well No.

Mail this copy to Board of Water Commissioners 429 Miss. St. Jackson, Miss.