

CLARKE


MISSISSIPPI BOARD OF WATER COMMISSIONERS

WATER WELL DRILLERS LOG

3 67
2-62

Date: Feb, 1962, Driller: Peoples + Rutledge County, Clarke
(Name)

(1) Owner of Land: <u>W. F. Allen</u> (Name)	Description & Color of Materials Sand, Clay, Red Clay, Shell, etc.	Thick- ness Feet	Depth Feet
<u>Stonewall, Miss</u> (Address)	<u>top soil to yellow sand</u>	42	42
(2) Location: <u>NW 1/4, NE 1/4, Sec. 9 T3R15</u>	<u>yellow clay</u>	4	46
<u>1</u> miles <u>S E</u> of <u>Stonewall</u> (distance) (direction) (Nearest Town)	<u>yellow sand + yellow clay streaks</u>	38	84
(3) Topography: <u>flat to hilly</u> (Hilly) (Flat) (Level)	<u>blue marl</u>	28	112
(4) Purpose of Well: <u>Domestic</u> (Domestic Irrigation, Municipal, Industrial, Other)	<u>Rock</u>	12	124
Information upon completion of well:	<u>Green sand + chert</u>	15	139
(1) Diameter <u>4</u> inches.	<u>Green shale + Rock</u>	50	189
(2) Total Depth <u>368</u> feet.	<u>white sand</u>	6	195
(3) Water Level <u>18</u> feet below top of ground.	<u>Green rock + shale</u>	63	258
(4) Cased to <u>148</u> , Size <u>4"</u>	<u>Gray sandy shale</u>	27	283
(5) Screen: Size <u>None</u> , Length _____	<u>white sand + small gray shale streaks</u>	32	315
(6) Were any formations sealed against pollution? <input checked="" type="checkbox"/> yes, <input type="checkbox"/> no.	<u>gray sandy shale + small black sand streaks</u>	21	336
If YES depth of formation <u>84</u>	<u>salt + pepper sand</u>	27	363
Why <u>surface strata</u>	<u>dark gumbo</u>	5	368
Drillers Remarks:			

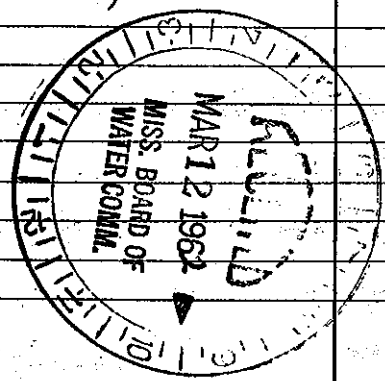

(Use Back Side)

Well No.

Mail this copy to Board of Water Commissioners 429 Miss. St. Jackson, Miss