

Clarke

MISSISSIPPI BOARD OF WATER COMMISSIONERS

P

3 ~~27~~ G10  
6-66

WATER WELL DRILLERS LOG

Date: June, 1966, Driller: Peeples Drilling Co County Clarke  
(Name)


(1) Owner of Land: Robert Kennedy  
(Name)  
R+1  
Quitman Miss  
(Address)  
NW 1/4, SE 25 3 1/4  
(2) Location: SW 1/4, NE 1/4, Sec. 30 T9 N R 6 E  
2 miles NE, of Quitman  
(distance) (direction) (Nearest Town)  
(3) Topography: Flat  
(Hilly) (Flat) (Level)  
(4) Purpose of Well: Home  
(Domestic Irrigation  
Municipal, Industrial, Other)

| Description & Color of Materials<br>Sand, Clay, Red Clay, Shell, etc. | Thick-<br>ness<br>Feet | Depth<br>Feet |
|---|------------------------|---------------|
| <u>Yellow Sandy Clay</u>  | <u>25</u>              | <u>25</u>     |
| <u>Blue shale</u>   | <u>28</u>              | <u>53</u>     |
| <u>Gray sand &amp; shale Riv.</u>                                     | <u>40</u>              | <u>93</u>     |
| <u>Green lime &amp; limestone</u>                                     | <u>77</u>              | <u>170</u>    |
| <u>White sand &amp; Brown</u>   |                        |               |
| <u>shale streaks</u>  | <u>60</u>              | <u>230</u>    |
| <u>Brown sand</u>   | <u>28</u>              | <u>258</u>    |

Information upon completion of well:

(1) Diameter 2 inches.  
(2) Total Depth 258 feet.  
(3) Water Level 41 feet below top of ground.  
(4) Cased to 252', Size 2"  
(5) Screen: Size 2", Length 6'  
(6) Were any formations sealed against pollution?  
no

If YES depth of formation \_\_\_\_\_  
Why \_\_\_\_\_  
Drillers Remarks: \_\_\_\_\_

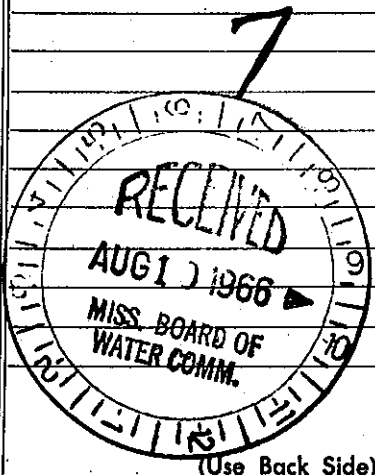

Well No.

Mail this copy to Board of Water Commissioners 429 Miss. St. Jackson. Miss