

Clarke
 B G 13
 10-66

MISSISSIPPI BOARD OF WATER COMMISSIONERS

P

WATER WELL DRILLERS LOG

Date: Oct, 1966, Driller: Peoples Drilling Co County Clarke
 (Name)


(1) Owner of Land:	Description & Color of Materials Sand, Clay, Red Clay, Shell, etc.	Thick- ness Feet	Depth Feet
<u>Smith</u> (Name)	<u>White sand</u>	<u>35</u>	<u>35</u>
<u>Stonewall, Miss.</u> (Address)	<u>Blue Clay</u>	<u>49</u>	<u>84</u>
(2) Location: <u>SW 1/4, NE 1/4, Sec. 6 T3R15</u>	<u>Blue clay & Rock</u>	<u>21</u>	<u>105</u>
<u>3/4 miles W</u> of <u>Stonewall</u> (distance) (direction) (Nearest Town)	<u>Green sand & chert</u>	<u>23</u>	<u>128</u>
(3) Topography: <u>Flat</u> (Hilly) (Flat) (Level)	<u>Blue Marl & Rock</u>	<u>103</u>	<u>231</u>
(4) Purpose of Well: <u>Home</u> (Domestic Irrigation Municipal, Industrial, Other)	<u>Gray sand & shale</u>		
	<u>+ small sand & shale</u>	<u>42</u>	<u>273</u>
	<u>White sand & shale</u>		
	<u>streaks</u>	<u>42</u>	<u>315</u>

Information upon completion of well:

- (1) Diameter 4 inches.
- (2) Total Depth 315 feet.
- (3) Water Level 7 feet below top of ground.
- (4) Cased to 130', Size 4"
- (5) Screen: Size NONE Length _____
- (6) Were any formations sealed against pollution?
 yes, _____ no.

If YES depth of formation 35'
 Why Possible Pollution

Drillers Remarks: _____

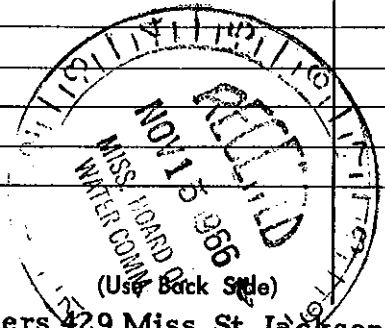

Well No. _____

Mail this copy to Board of Water Commissioners 429 Miss. St. Jackson, Miss.