

Clarke
3 G15
4-67

MISSISSIPPI
BOARD OF WATER COMMISSIONERS
416 North State Street
Jackson, Mississippi 39201

WATER WELL DRILLERS LOG

APR 6 1967 PEEPLES DRILLING CO CLARKE
date well completed firm name county well located

LANDOWNER: OTIS BLAND

QUITMAN MISS

RFD

(mailing address)

WELL LOCATION:

sec. 15 T. 3 N. R. 15 E.

3 1/2 miles N of QUITMAN
(distance) (direction) (nearest town)

WELL PURPOSE: HOME
(home, irrigation, municipal, industrial)

WELL COMPLETION DATA:

- (1) diameter (inches) 4
- (2) total depth (feet) 378'
- (3) static water level (feet) 21' below top of ground.
- (4) casing IRON 210' (material) (depth)
4" (size) If telescope see back.
- (5) screen NONE (length) (depth to top)
(size) (material)
- (6) pump 1/3 (HP) 10 (yield gpm)
ELECT (type power)
- (7) electric log NO (yes or no)
(organization running log)
- (8) how well bottom plugged OPEN

description of formations encountered

from to

YELLOW SAND + SMALL CLAY STREAKS 0 126


BLUE SHALE + SANDY SHALE 126 147

BLUE ROCK + SMALL SAND STREAKS 147 200

BLUE MARL + ROCK 200 293

GRAY SANDY SHALE + SMALL SAND STREAKS 293 349

BLUE SAND 349 378

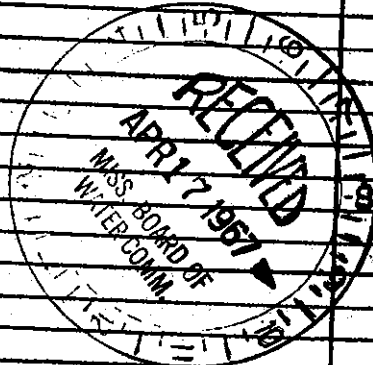

DRILLERS REMARKS: