

P

MISSISSIPPI
BOARD OF WATER COMMISSIONERS
416 North State Street
Jackson, Mississippi 39201

WATER WELL DRILLERS LOG

Clark
3 G23
2-68

2.12.68 19 McDonald + Hill CLARK
date well completed firm name county well located


LANDOWNER, <u>HACKEL MARTIN</u> <u>STONEWALL MISS</u> (mailing address)	description of formations encountered	from to	
	Clay	0	18
	Sand	18	55
	Shale	55	82
	LIME ROCK	82	91
	SANDS	91	112
	Soft Shale	112	122
	Rocky Shale	122	210
	Shale	210	250
	Sand	250	280

WELL LOCATION:
sec. 3 T. 3 N R. 15 E
S W
3 miles EAST of STONEWALL
(distance) (direction) (nearest town)

WELL PURPOSE: HOME
(home, irrigation, municipal, industrial)

WELL COMPLETION DATA:

- (1) diameter (inches) 4"
- (2) total depth (feet) 280
- (3) static water level (feet) 28' below ~~ground~~ plunge top of ground.
- (4) casing BLACK, 80'
(material) (depth)
4" if telescope see back.
(size)
- (5) screen NO, NO
(length) (depth to top)
NO, NO
(size) (material)
- (6) pump 3 JET, 8
(HP) (yield gpm)
330
(type power)
- (7) electric log NO
(yes or no)
NO
(organization running log)
- (8) how well bottom plugged OPEN

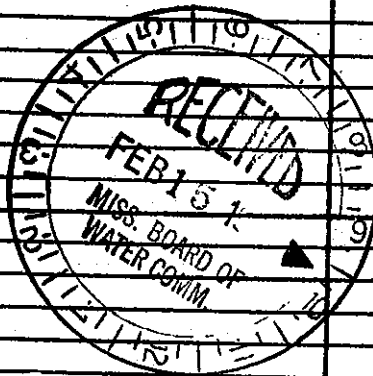

DRILLERS REMARKS: