

CLARKE

MISSISS.

5 G 24

WATER WELL DRILLERS LOG

G 300 P

7-9-60

Date: 7-9, 1960, Driller: Peoples of Rutledge County Clarke

(Name)

		Description & Color of Materials Sand, Clay, Red Clay, Shell, etc.	Thick- ness Feet	Depth Feet
(1) Owner of Land: <u>Water Barney</u> (Name)		Red sandy shale	12	12
<u>Stonewall Miss</u> (Address)		Red to yellow sand	78	90
(2) Location: $\frac{1}{4}$, $\frac{1}{4}$, Sec. <u>9</u> T. <u>3R15</u> , <u>Stonewall</u>		Black shale to chert	35	125
<u>1/2</u> miles <u>S-East</u> , of <u>Stonewall</u> (distance) (direction) (Nearest Town)		Shale & Rock Hard	158	283
(3) Topography: <u>Hilly</u> (Hilly) (Flat) (Level)		Blue sandy shale	11	294
(4) Purpose of Well: <u>Domestic</u> (Domestic Irrigation Municipal, Industrial, Other)		Sand	73	367


Information upon completion of well:

- (1) Diameter 4" inches.
- (2) Total Depth 367 feet.
- (3) Water Level ~~127~~ 60' feet below top of ground.
- (4) Cased to 127, Size 4"
- (5) Screen: Size _____, Length _____
- (6) Were any formations sealed against pollution?
_____ yes, _____ no.

If YES depth of formation _____

Why _____

Drillers Remarks: _____

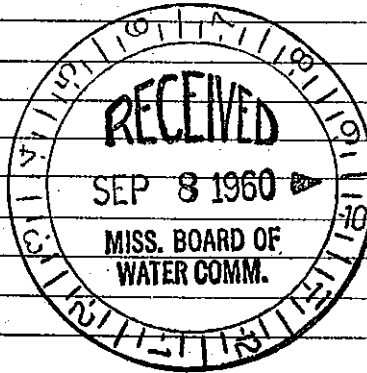

(Use Back Side)

Well No.

Retain this copy for your office files.