

CLARK
5627
1-64


MISSISSIPPI BOARD OF WATER COMMISSIONERS

P

WATER WELL DRILLERS LOG

Date: Jan, 1964, Driller: Peoples Drilling Co County: Clarke
(Name)

	Description & Color of Materials Sand, Clay, Red Clay, Shell, etc.	Thick- ness Feet	Depth Feet
(1) Owner of Land: <u>Thomson</u> (Name) <u>Stonewall, Miss</u> (Address)	Red sandy clay	12	12
	Yellow Sand	18	30
(2) Location: $\frac{1}{4}$, $\frac{1}{4}$, Sec <u>5</u> <u>3N15E</u> T R <u>9 miles</u> of <u>Stonewall</u> (distance) (direction) (Nearest Town)	Yellow sand & clay	85	115
	Gray sandy shale	11	126
	Blue marl	19	145
(3) Topography: <u>Hilly</u> (Hilly) (Flat) (Level)	Rock & blue marl	12	157
	Green chert & sand	13	170
(4) Purpose of Well: <u>Home</u> (Domestic Irrigation Municipal, Industrial, Other)	Blue marl & rock	120	290
	Gray sandy shale	13	303
	White sand	33	336
	Gray sandy shale		
	& sand streak	21	357
Information upon completion of well:			
(1) Diameter <u>4</u> inches.			
(2) Total Depth <u>357</u> feet.			
(3) Water Level <u>90</u> feet below top of ground.			
(4) Cased to <u>147'</u> , Size <u>4"</u>			
(5) Screen: Size <u>NONE</u> , Length _____			
(6) Were any formations sealed against pollution? _____ yes, _____ no.			
If YES depth of formation _____			
Why _____			
Drillers Remarks: _____			

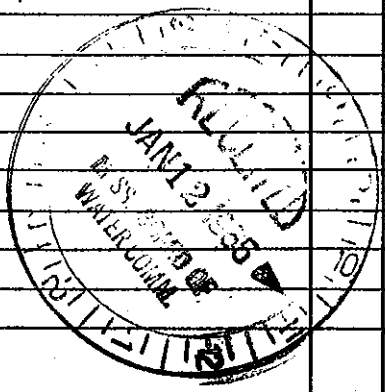

(Use Back Side)

Well No.

Mail this copy to Board of Water Commissioners 429 Miss. St. Jackson, Miss.