

CLARKE MISSISSIPPI BOARD OF WATER COMMISSIONERS

5 **629**
6-64

WATER WELL DRILLERS LOG

Date: June, 1964, Driller: Peeples Drilling Co County Clarke
(Name)

(1) Owner of Land: <u>George Sinclair</u> (Name) &	Description & Color of Materials Sand, Clay, Red Clay, Shell, etc.	Thick- ness Feet	Depth Feet
<u>Stonewall, Miss</u> (Address)	<u>Red Sandy clay</u>	<u>12</u>	<u>12</u>
(2) Location: <u>3N15E</u> <u>1/4</u> , <u>1/4</u> , Sec. <u>5</u> T. <u>R.</u>	<u>Red Sand</u>	<u>40</u>	<u>52</u>
<u>Town of Stonewall</u> (distance) miles (direction) of (Nearest Town)	<u>Yellow Sand</u>	<u>11</u>	<u>63</u>
(3) Topography: <u>Hilly</u> (Hilly) (Flat) (Level)	<u>Gray clay</u>	<u>38</u>	<u>101</u>
(4) Purpose of Well: <u>Home</u> (Domestic Irrigation Municipal, Industrial, Other)	<u>Gray sand</u>	<u>14</u>	<u>115</u>
	<u>Gray sandy shale</u>	<u>21</u>	<u>136</u>
	<u>Blue marl rock</u>	<u>157</u>	<u>294</u>
	<u>Gray sandy shale</u>	<u>21</u>	<u>315</u>
	<u>White sand</u>	<u>21</u>	<u>336</u>


Information upon completion of well:

- (1) Diameter 4 inches.
- (2) Total Depth 336 feet.
- (3) Water Level 90 feet below top of ground.
- (4) Cased to 147', Size 4"
- (5) Screen: Size NONE, Length _____
- (6) Were any formations sealed against pollution?
_____ yes, _____ no.

If YES depth of formation _____

Why _____

Drillers Remarks: _____

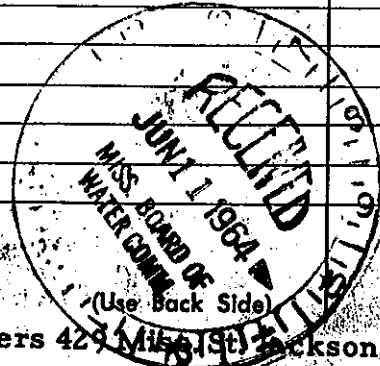

Well No. _____

Mail this copy to Board of Water Commissioners 429 Miss Jackson, Miss