

CLARKE
5630
2-65

MISSISSIPPI BOARD OF WATER COMMISSIONERS

P

WATER WELL DRILLERS LOG

Date: Feb, 1965, Driller: Peoples Drilling Co County Clarke
(Name)

(1) Owner of Land: <u>A. J. Bradley</u> (Name)	Description & Color of Materials Sand, Clay, Red Clay, Shell, etc.	Thick- ness Feet	Depth Feet
<u>Stonewall, Miss</u> (Address)	<u>Yellow sandy clay</u>		
	<u>& sand</u>	32	32
(2) Location: <u>town of Stonewall</u> <u>town of Stonewall</u> miles, of	<u>yellow sand</u>	46	78
(distance) (direction) (Nearest Town)	<u>Blue marl & sand</u> <u>streaks</u>	37	115
(3) Topography: <u>Hilly</u> (Hilly) (Flat) (Level)	<u>Blue marl & Rock</u>	10	125
(4) Purpose of Well: <u>Home</u> (Domestic Irrigation Municipal, Industrial, Other)	<u>Green sand & chert</u>	15	140
	<u>blue marl & Rock</u>	150	290
	<u>gray sandy shale</u>	10	300
	<u>white sand</u>	27	327


Information upon completion of well:

- (1) Diameter 4 inches.
- (2) Total Depth 327 feet.
- (3) Water Level 90 feet below top of ground.
- (4) Cased to 189', Size 4"
- (5) Screen: Size 2", Length 12'
- (6) Were any formations sealed against pollution?
_____ yes, _____ no.

If YES depth of formation _____

Why _____

Drillers Remarks: _____

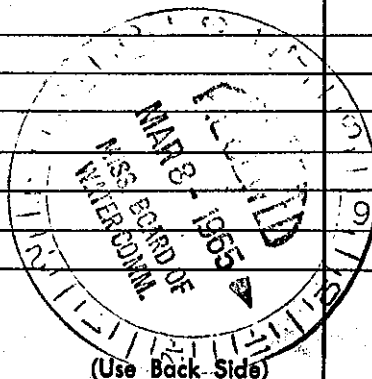

Well No. _____

Mail this copy to Board of Water Commissioners 429 Miss. St. Jackson, Miss.