

CLARKE
5 G 32
10-65

MISSISSIPPI BOARD OF WATER COMMISSIONERS

P

WATER WELL DRILLERS LOG

Date: Oct, 1965, Driller Reeple Drilling Co County Clarke
(Name)

(1) Owner of Land: <u>Lamar Sharty William</u> (Name)	Description & Color of Materials Sand, Clay, Red Clay, Shell, etc.	Thick- ness Feet	Depth Feet
<u>Stonewall, Miss</u> (Address)	<u>Yellow Sand</u>	<u>55</u>	<u>55</u>
(2) Location: <u>1/4, 1/4, Sec. 5 T. 1 R. 3N 15E</u>	<u>Blue sand + blue clay streaks</u>	<u>8</u>	<u>43</u>
_____ miles _____ of _____ (distance) (direction) (Nearest Town)	<u>Gray sandy shale</u>	<u>21</u>	<u>84</u>
(3) Topography: <u>Flat</u> (Hilly) (Flat) (Level)	<u>Green rock + blue marl streaks</u>	<u>21</u>	<u>105</u>
(4) Purpose of Well: <u>Home</u> (Domestic Irrigation Municipal, Industrial, Other)	<u>Green sand</u>	<u>15</u>	<u>120</u>
	<u>Blue marl + rock</u>	<u>132</u>	<u>252</u>
	<u>Gray sandy shale</u>	<u>12</u>	<u>264</u>
	<u>White sand +</u>		
	<u>gray shale streak</u>	<u>36</u>	<u>300</u>


Information upon completion of well:

- (1) Diameter 4 inches.
- (2) Total Depth 300 feet.
- (3) Water Level 15 feet below top of ground.
- (4) Cased to 120', Size 4"
- (5) Screen: Size NONE, Length _____.
- (6) Were any formations sealed against pollution?
_____ yes, _____ no.

If YES depth of formation _____

Why _____

Drillers Remarks: _____

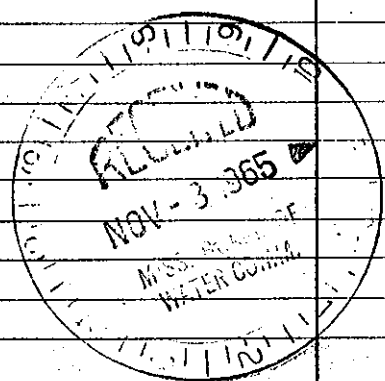

Well No.

(Use Back Side)

Mail this copy to Board of Water Commissioners 429 Miss. St. Jackson. Miss