


CLARKE MISSISSIPPI BOARD OF WATER COMMISSIONERS

D

635
5 1-15-64

WATER WELL DRILLERS LOG

Date: 1-15, 1964, Driller: Mr. Daniel H. ...
(Name)

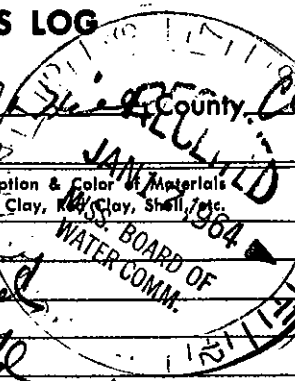

(1) Owner of Land: Arviston Jordan
(Name)

Stonesville
(Address)

(2) Location: 1/4, 1/4, Sec. 4 T. R
3N 14E

1 miles E of Stonesville
(distance) (direction) (Nearest Town)

(3) Topography: Hilly
(Hilly) (Flat) (Level)

(4) Purpose of Well: Domestic
(Domestic Irrigation, Municipal, Industrial, Other)

Description & Color of Materials Sand, Clay, Shell, etc.	Thickness Feet	Depth Feet
Clay	6	6
Clay	90	90
Clay	97	97
Sand	97	120
Soft shale	120	120
Shale	120	123
Hard lime rock	123	127
lime & lime shale	127	160
shale & sandy shale	160	179
shale w/ lime st.	179	230
#12 sand	230	237
shale w/ lime st.	237	260

Information upon completion of well:

(1) Diameter 4 inches.

(2) Total Depth 260 feet.

(3) Water Level 80 feet below top of ground.

(4) Cased to 180, Size 4

(5) Screen: Size _____, Length _____

(6) Were any formations sealed against pollution?
_____ yes, _____ no.

If YES depth of formation _____

Why _____

Drillers Remarks: _____

Well No.

(Use Back Side)

Mail this copy to Board of Water Commissioners 429 Miss. St. Jackson, Miss.