

WATER COMMISSIONERS

130

WATER WELL DRILLERS LOG

pt CLARKE 1963, Driller: Pepper County Clarke
 (Name)

5
 6-36
 9-63

(1) Owner of Land: Stonewall Miss
 (Name)
Stonewall Miss
 (Address)

(2) Location: 3/4 miles E of Stonewall
 (distance) (direction) (Nearest Town)
3/4 miles E of Stonewall
 (distance) (direction) (Nearest Town)

(3) Topography: Hilly
 (Hilly) (Flat) (Level)

(4) Purpose of Well: Domestic
 (Domestic Irrigation
 Municipal, Industrial, Other)

Description & Color of Materials Sand, Clay, Red Clay, Shell, etc.	Thick- ness Feet	Depth Feet
Yellow Sand	53	53
Blue mud	27	80
Rock	14	94
Green Sand	21	115
Blue mud + rock strata	105	220
Gray sandstone	32	252
White sandstone		
stale slush	42	294

Information upon completion of well:

(1) Diameter 4 inches.

(2) Total Depth 294 feet.

(3) Water Level _____ feet below top of ground.

(4) Cased to 120', Size 4"


(5) Screen: Size none, Length _____

(6) Were any formations sealed against pollution?
 _____ yes, _____ no.

If YES depth of formation _____

Why _____

Drillers Remarks: _____

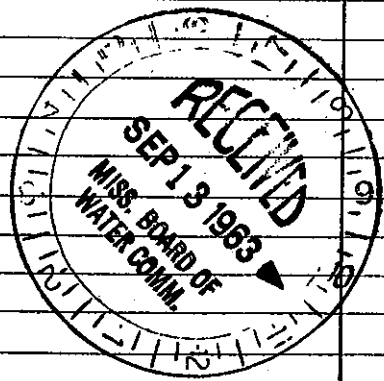

Well No.

(Use Back Side)

Mail this copy to Board of Water Commissioners 429 Miss. St. Jackson, Miss