


637
5-27-63

WATER WELL DRILLERS LOG

Date: 5-27, 1963, Driller: McDonald & Hill County, Clarke
(Name)

(1) Owner of Land: (Name)	Description & Color of Materials Sand, Clay, Red Clay, Shell, etc.	Thick- ness Feet	Depth Feet
Pulley	Clay	0	4
(Address)	Sls. & Clay	4	41
(2) Location: 1/4, 1/4, Sec. 3 T. R.	Shale	41	45
2 miles East of Stennis	Sls. & Chert	40	75
(3) Topography: Hilly (Flat) (Level)	Sls.	75	89
(4) Purpose of Well: Domestic (Domestic Irrigation Municipal, Industrial, Other)	Sls. w/ some shale	89	105
Information upon completion of well:	Shale w/ some lime	105	119
(1) Diameter 3 1/4 inches.	Hard lime rock	119	130
(2) Total Depth 310 feet.	Sls. shale & sd	130	145
(3) Water Level 86 feet below top of ground.	Shale w/ lime st.	145	165
(4) Cased to 137, Size 4	Lime & limy shale	165	170
(5) Screen: Size, Length	Sls. shale	170	265
(6) Were any formations sealed against pollution?	Shale	265	278
yes, no.	Sls	278	310
If YES depth of formation			
Why			
Drillers Remarks:			

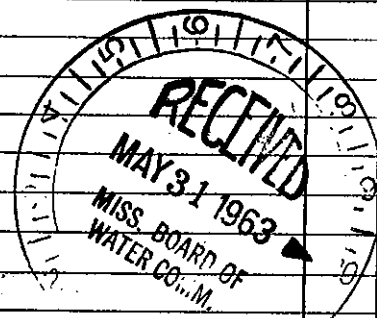

(Use Back Side)

Well No.

Mail this copy to Board of Water Commissioners 429 Miss. St. Jackson, Miss