

CLARKE

MISSISSIPPI BOARD OF WATER COMMISSIONERS

P

G 38

5-30-63

WATER WELL DRILLERS LOG

Date: 0-30, 1963, Driller: Mr. Daniel L. Hill County Clarke
(Name)

(1) Owner of Land: <u>Joe Dabney</u> (Name)	Description & Color of Materials Sand, Clay, Red Clay, Shell, etc.	Thick- ness Feet	Depth Feet
<u>Stonewall</u> (Address)	<u>Clay</u>	<u>0</u>	<u>12</u>
(2) Location: <u>1/4, 1/4, Sec. 3 31 N 15 E</u> T R	<u>Sand</u>	<u>12</u>	<u>123</u>
<u>2 miles East</u> of <u>Stonewall</u> (distance) (direction) (Nearest Town)	<u>Shale</u>	<u>123</u>	<u>?</u>
(3) Topography: <u>Hilly</u> (Hilly) (Flat) (Level)			
(4) Purpose of Well: <u>Domestic</u> (Domestic Irrigation Municipal, Industrial, Other)			


Information upon completion of well:

- (1) Diameter 3 1/4 inches.
- (2) Total Depth 120 feet.
- (3) Water Level 60 feet below top of ground.
- (4) Cased to 117, Size 2"
- (5) Screen: Size 2", Length 5'
- (6) Were any formations sealed against pollution?
_____ yes, _____ no.

If YES depth of formation _____

Why _____

Drillers Remarks: _____

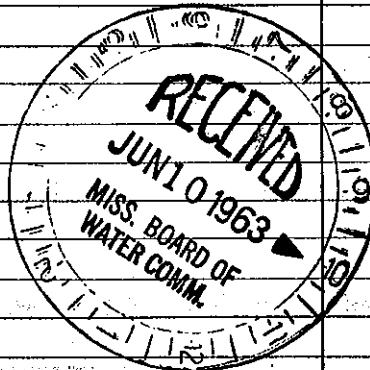

(Use Back Side)

Well No.

Mail this copy to Board of Water Commissioners 429 Miss. St. Jackson, Miss