

CLARKE MISSISSIPPI BL

G 40
2-63

WATER WELL DRILLERS LOG

Date: Feb, 1962, Driller: Peoples Drilling Co, Clarke County, Clarke

| | Description & Color of Materials Sand, Clay, Red Clay, Shell, etc. | Thick- ness Feet | Depth Feet |
|---|---|------------------------|---------------|
| (1) Owner of Land: <u>H. Hamrick</u> (Name) <u>Stonewell, Miss</u> (Address) | <u>Red Sand & Clay</u> | <u>12</u> | <u>12</u> |
| (2) Location: <u>1/4</u> , <u>1/4</u> , Sec <u>3</u> <u>3N 15E</u> (distance) (direction) (Nearest Town) | <u>yellow sand & clay streaks</u> | <u>19</u> | <u>31</u> |
| (3) Topography: <u>Hilly</u> (Hilly) (Flat) (Level) | <u>White sand</u> | <u>21</u> | <u>52</u> |
| (4) Purpose of Well: <u>Domestic</u> (Domestic Irrigation Municipal, Industrial, Other) | <u>White sand & clay streaks</u> | <u>21</u> | <u>73</u> |
| | <u>White sand</u> | <u>7</u> | <u>80</u> |


Information upon completion of well:

- (1) Diameter 2 inches.
- (2) Total Depth 80 feet.
- (3) Water Level 40 feet below top of ground.
- (4) Cased to 75, Size _____
- (5) Screen: Size 2", Length 6'
- (6) Were any formations sealed against pollution?
_____ yes, no.

If YES depth of formation _____

Why _____

Drillers Remarks: _____

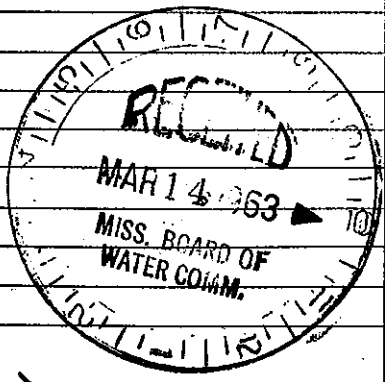

(Use Back Side)

Well No.

Mail this copy to Board of Water Commissioners 429 Miss. St. Jackson, Miss