

CLARKE MISSISSIPPI BOARD OF WATER COMMISSIONERS

5641  
10-10-61

WATER WELL DRILLERS LOG

Clarke  
Franklin

10-10-1, 1961, Driller: McDonald Hill County Franklin  
(Name)

Owner of Land: ROBERT WILLIAMS  
(Name)

STONEWALL MISS  
(Address)

Description & Color of Materials Sand, Clay, Red Clay, Shell, etc.	Thick- ness Feet	Depth Feet
CLAY	0	8
SAND	8	44
SHALE	44	65
LIME ROCK SHALE	65	100
SOFT SHALE	100	125
SOFT SANDY SHALE	125	140
SHALE STRUCK	140	230
SAND	230	250

(2) Location: 1/4, 1/4, Sec. 3 3N 15E  
T. R.

9 miles EAST of STONEWALL  
(distance) (direction) (Nearest Town)

(3) Topography: X  
(Hilly) (Flat) (Level)

(4) Purpose of Well: DOMESTIC  
(Domestic Irrigation  
Municipal, Industrial, Other)


Information upon completion of well:

- (1) Diameter 3 1/2 inches.
- (2) Total Depth 250 feet.
- (3) Water Level 20' feet below top of ground.
- (4) Cased to 148', Size 3"
- (5) Screen: Size \_\_\_\_\_, Length \_\_\_\_\_
- (6) Were any formations sealed against pollution?  
\_\_\_\_\_ yes, \_\_\_\_\_ no.

If YES depth of formation \_\_\_\_\_

Why \_\_\_\_\_

Drillers Remarks: \_\_\_\_\_

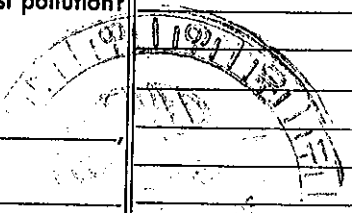

(Use Back Side)

Well No.

Mail this copy to Board of Water Commissioners 429 Miss. St. Jackson, Miss.