

5642
9-1-65

WATER WELL DRILLERS LOG

Date: SEPT 1, 1965, Driller: Peoples Drilling Co. Clarke
(Name)

(1) Owner of Land: <u>ALICE GOODWIN</u> (Name)	Description & Color of Materials Sand, Clay, Red Clay, Shell, etc.	Thick- ness Feet	Depth Feet
<u>P.O. BOX #75 STONEWALL</u> (Address)	<u>Yellow Sandy clay</u>	<u>18</u>	<u>18</u>
(2) Location: <u>1/4, 1/4, Sec. 9</u> T. R.	<u>Yellow Sand & clay</u>		
<u>3</u> miles <u>S</u> of <u>Stonewall</u> (distance) (direction) (Nearest Town)	<u>Breaks</u>	<u>110</u>	<u>128</u>
(3) Topography: <u>Hilly</u> (Hilly) (Flat) (Level)	<u>Blue clay</u>	<u>32</u>	<u>160</u>
(4) Purpose of Well: <u>Home</u> (Domestic Irrigation Municipal, Industrial, Other)	<u>Blue rock & clay</u>	<u>20</u>	<u>180</u>
	<u>Green Sand</u>	<u>9</u>	<u>189</u>
	<u>Blue Rock & Marl</u>	<u>121</u>	<u>310</u>
	<u>Gray shale</u>	<u>8</u>	<u>318</u>
	<u>White Sand</u>	<u>40</u>	<u>378</u>

Information upon completion of well:

(1) Diameter 4 inches.

(2) Total Depth 378 feet.

(3) Water Level 86 feet below top of ground.

(4) Cased to 147', Size 4"


(5) Screen: Size NONE, Length _____

(6) Were any formations sealed against pollution?
_____ yes, _____ no.

If YES depth of formation _____

Why _____

Drillers Remarks: _____

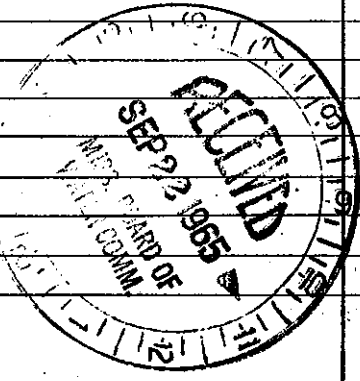

(Use Back Side)

Well No.