

CLARKE

MISSISSIPPI BOARD OF WATER COMMISSIONERS

643
3-62

P1

WATER WELL DRILLERS LOG

Date: March, 1962, Driller: Peeples + Kullidge County Clarke
(Name)

(1) Owner of Land: <u>Evans</u> (Name)	Description & Color of Materials Sand, Clay, Red Clay, Shell, etc.	Thick- ness Feet	Depth Feet
<u>Stonewall, Miss</u> (Address)	0-50 <u>Top Sand</u>	<u>30</u>	<u>30</u>
(2) Location: <u>1/4, 1/4, Sec. 5</u> ^{3N 15E} <u>T R</u>	<u>Shale.</u>	<u>50</u>	<u>80</u>
<u>1/4</u> miles <u>SE</u> , of <u>Stonewall</u> (distance) (direction) (Nearest Town)	<u>Hard Rock</u>	<u>160</u>	<u>240</u>
(3) Topography: <u>Flat</u> (Hilly) (Flat) (Level)	<u>Sand.</u>	<u>40</u>	<u>280</u>
(4) Purpose of Well: <u>Domestic</u> (Domestic Irrigation Municipal, Industrial, Other)			


Information upon completion of well:

- (1) Diameter 4" inches.
- (2) Total Depth 284 feet.
- (3) Water Level Flow feet below top of ground.
- (4) Cased to 84', Size 4"
- (5) Screen: Size NONE, Length _____
- (6) Were any formations sealed against pollution?
_____ yes, _____ no.

If YES depth of formation _____

Why _____

Drillers Remarks: _____

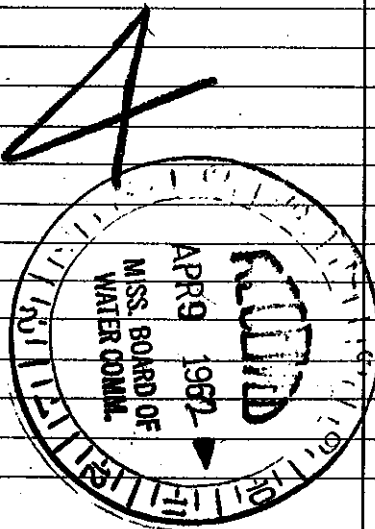

(Use Back Side)

Well No.

Mail this copy to Board of Water Commissioners 429 Miss. St. Jackson, Miss