

5 G 44
4-66

WATER WELL DRILLERS LOG

Date: April, 1966, Driller: Peoples Drilling Co County: Clarke
(Name)

(1) Owner of Land: Asstzela Davis
(Name)

(Address)

(2) Location: 1/4, 1/4, Sec. 9 3N15E T. R.
1 1/2 miles SE of Stonewell
(distance) (direction) (Nearest Town)

(3) Topography: Hilly
(Hilly) (Flat) (Level)

(4) Purpose of Well: Home
(Domestic Irrigation
Municipal, Industrial, Other)

Description & Color of Materials Sand, Clay, Red Clay, Shell, etc.	Thick- ness Feet	Depth Feet
<u>Yellow sandy clay</u>	<u>18</u>	<u>18</u>
<u>Yellow sand</u>		
<u>Small clay streak</u>	<u>112</u>	<u>130</u>
<u>Blue marl & rock</u>	<u>30</u>	<u>160</u>
<u>Green sand & chert</u>	<u>19</u>	<u>179</u>
<u>Blue marl & rock</u>	<u>124</u>	<u>305</u>
<u>Gray sandy shale & sand streak</u>	<u>20</u>	<u>325</u>
<u>White sand & shale streak</u>	<u>27</u>	<u>357</u>

Information upon completion of well:

(1) Diameter 4 inches.

(2) Total Depth 357 feet.

(3) Water Level 73 feet below top of ground.

(4) Cased to 147', Size 4"


(5) Screen: Size NONE, Length _____

(6) Were any formations sealed against pollution?
_____ yes, _____ no.

If YES depth of formation _____

Why _____

Drillers Remarks: _____

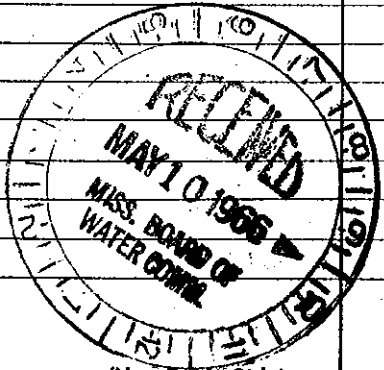

(Use Back Side)

Well No.

Mail this copy to Board of Water Commissioners 429 Miss. St. Jackson, Miss