

CLARK  
647  
8-63

MISSISSIPPI BOARD OF WATER COMMISSIONERS

WATER WELL DRILLERS LOG

Date: Aug, 1963, Driller: Peoples Drilling, County: Clarke  
(Name)

(1) Owner of Land:	Description & Color of Materials	Thick- ness Feet	Depth Feet
(Name)	White sand	52	52
(Address)	Blue mud	23	75
(2) Location: 1/4, 1/4, Sec. 7 3N 15E T. R.	Blue mud & Rock	19	94
1 miles 5, of Standard (distance) (direction) (Nearest Town)	Green sand	11	115
(3) Topography: Flat (Hilly) (Flat) (Level)	Blue mud & Rock	126	241
(4) Purpose of Well: Domestic (Domestic Irrigation Municipal, Industrial, Other)	Gray sandy shale	11	252
	White sand & small shale streaks	31	283


Information upon completion of well:

- (1) Diameter 4" inches.
- (2) Total Depth 283 feet.
- (3) Water Level 760W feet below top of ground.
- (4) Cased to 124', Size 4"
- (5) Screen: Size NONE, Length.
- (6) Were any formations sealed against pollution?  
yes, no.

If YES depth of formation

Why

Drillers Remarks:

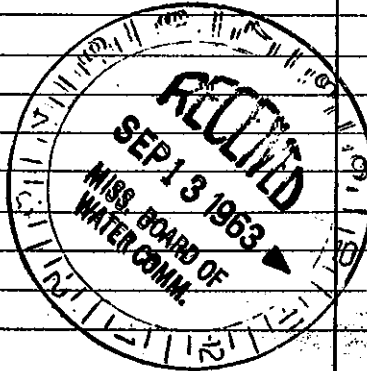

(Use Back Side)

Well No

Mail this copy to Board of Water Commissioners 429 Miss. St. r