

CLARKE MISSISSIPPI BOARD OF WATER COMMISSIONERS

S 649
6-64


WATER WELL DRILLERS LOG

Date: June, 1964, Driller: Reeple Drilling Co County Clarke
(Name)

(1) Owner of Land:	Description & Color of Materials Sand, Clay, Red Clay, Shell, etc.	Thick- ness Feet	Depth Feet
<u>Roy Williams</u> (Name) <u>Stonewall, Miss</u> (Address)	<u>Yellow Sand & Gravel</u>	<u>35</u>	<u>35</u>
(2) Location: <u>1/4</u> , <u>1/4</u> , Sec. <u>6</u> <u>3N 15E</u> T. <u>R</u>	<u>Blue marl</u>	<u>59</u>	<u>94</u>
<u>1</u> miles <u>W</u> of <u>Stonewall</u> (distance) (direction) (Nearest Town)	<u>Chert (Green)</u>	<u>26</u>	<u>120</u>
(3) Topography: <u>flat</u> (Hilly) (Flat) (Level)	<u>Blue marl & Rock</u>	<u>130</u>	<u>250</u>
(4) Purpose of Well: <u>Home</u> (Domestic Irrigation Municipal, Industrial, Other)	<u>Gray sandy shale</u>	<u>23</u>	<u>273</u>
	<u>W. blue sand & shale</u>	<u>21</u>	<u>294</u>

Information upon completion of well:

- (1) Diameter 4 inches.
- (2) Total Depth 294 feet.
- (3) Water Level Flow feet below top of ground.
- (4) Cased to 130', Size 4"
- (5) Screen: Size N 15 E, Length _____.
- (6) Were any formations sealed against pollution?
_____ yes, _____ no.
- If YES depth of formation _____
- Why _____
- Drillers Remarks: _____

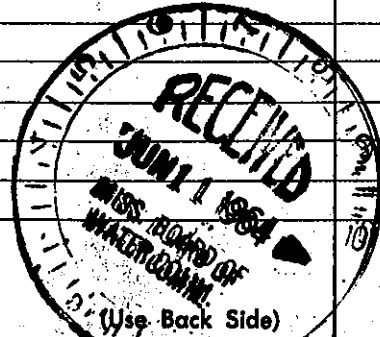

Well No. _____

Mail this copy to Board of Water Commissioners 429 Miss. St. Jackson, Miss