

5 650
5-64

WATER WELL DRILLERS LOG

Date: May, 1964, Driller: Peeples Drilling Co County Clarke
(Name)

(1) Owner of Land:	Description & Color of Materials Sand, Clay, Red Clay, Shell, etc.	Thick- ness Feet	Depth Feet
<u>Johnson</u> (Name) <u>Stonewall, Miss.</u> (Address)	<u>Yellow Sand + Gravel</u>	<u>40</u>	<u>40</u>
(2) Location: <u>1/4</u> , <u>1/4</u> , Sec. <u>6</u> <u>3N 15E</u> T R	<u>Blue marl</u>	<u>54</u>	<u>94</u>
<u>1/2</u> miles <u>W</u> , of <u>Stonewall</u> (distance) (direction) (Nearest Town)	<u>Green rock</u>	<u>11</u>	<u>105</u>
(3) Topography: <u>Flat</u> (Hilly) (Flat) (Level)	<u>Green Sand</u>	<u>15</u>	<u>120</u>
(4) Purpose of Well: <u>Domestic</u> (Domestic Irrigation Municipal, Industrial, Other)	<u>Blue marl + Rock</u>	<u>48</u>	<u>168</u>
	<u>Rock + Marl</u>	<u>73</u>	<u>241</u>
	<u>Gray sandy shale</u>	<u>21</u>	<u>262</u>
	<u>White sand</u>		
	<u>Gray shale streak</u>	<u>33</u>	<u>305</u>


Information upon completion of well:

- (1) Diameter 4 inches.
- (2) Total Depth 305 feet.
- (3) Water Level FLOW feet below top of ground.
- (4) Cased to 126', Size 4"
- (5) Screen: Size NONE Length _____
- (6) Were any formations sealed against pollution?
_____ yes, _____ no.

If YES depth of formation _____

Why _____

Drillers Remarks: _____

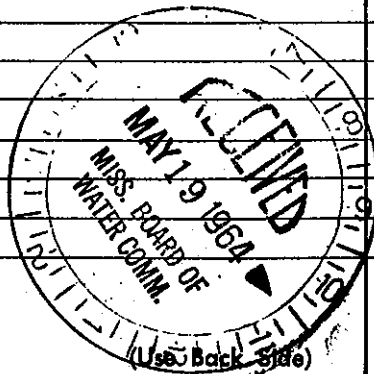

Well No. _____

Mail this copy to Board of Water Commissioners 429 Miss. St. Jackson, Miss