

CLARK

652  
5-63

# WATER WELL DRILLERS LOG

Date: May, 1963, Driller: Peeples Drilling Co County Clarke  
(Name)

(1) Owner of Land:	Description & Color of Materials Sand, Clay, Red Clay, Shell, etc.	Thick- ness Feet	Depth Feet
<u>Rogge Gro &amp; Service Station</u> <u>Stonewall Miss</u> (Address)	<u>Yellow Sand &amp; Gravel</u>		
(2) Location: <u>1/4</u> , <u>1/4</u> , Sec. <u>16</u> T <u>2N</u> R <u>15E</u>	<u>Green sandy clay</u>	<u>31</u>	<u>31</u>
<u>1/4</u> miles <u>W</u> , of <u>Stonewall</u>	<u>Green rock &amp; green sand streaks</u>	<u>32</u>	<u>63</u>
(3) Topography: <u>Flat</u>	<u>Green rock &amp; green sand streaks</u>	<u>52</u>	<u>115</u>
(4) Purpose of Well: <u>Service Station</u>	<u>Gray sandy shale</u>	<u>116</u>	<u>231</u>
(Domestic Irrigation Municipal, Industrial, Other)	<u>Coarse white sand</u>	<u>21</u>	<u>252</u>
	<u>White sand &amp; gray shale streaks</u>	<u>21</u>	<u>273</u>
		<u>42</u>	<u>315</u>


### Information upon completion of well:

- (1) Diameter 4 inches.
- (2) Total Depth 315 feet.
- (3) Water Level Flow feet below top of ground.
- (4) Cased to 126', Size 4"
- (5) Screen: Size None, Length \_\_\_\_\_
- (6) Were any formations sealed against pollution?  
\_\_\_\_\_ yes, \_\_\_\_\_ no.

If YES depth of formation \_\_\_\_\_

Why \_\_\_\_\_

Drillers Remarks: \_\_\_\_\_

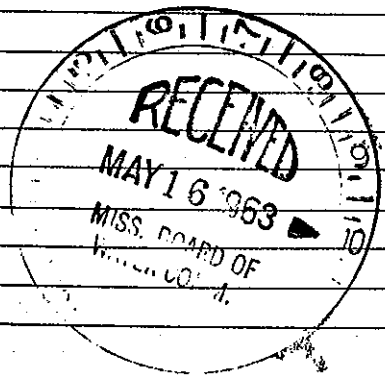

(Use Back Side)

Well No. \_\_\_\_\_

Mail this copy to Board of Water Commissioners 429 Miss. St. Jackson, Miss